


T. 3S., R. 3W., W. M.

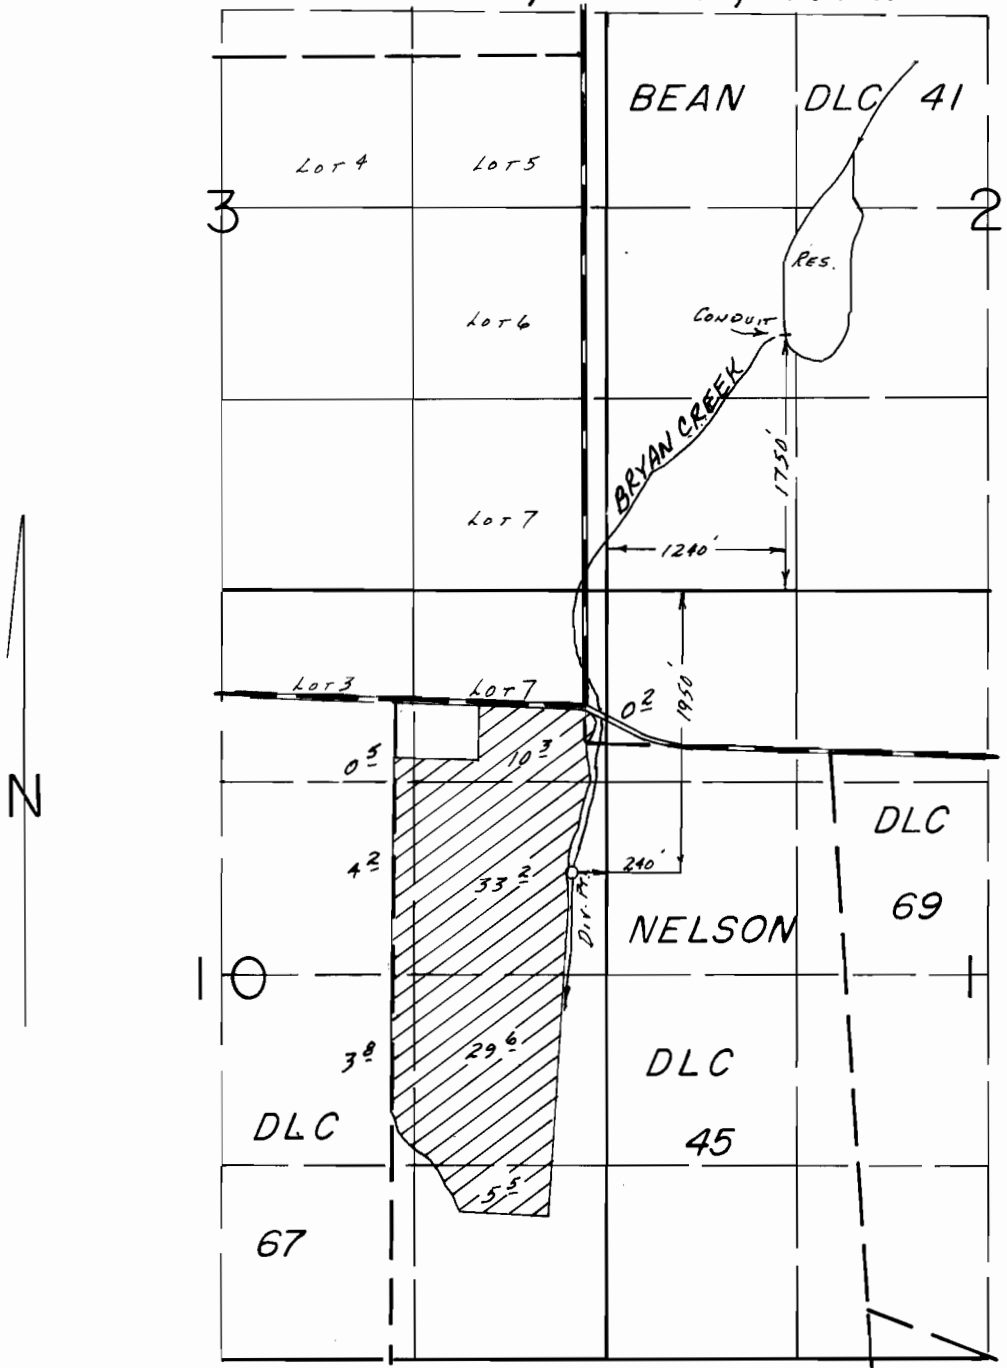

SCALE: 1" = 1320'

**FINAL PROOF SURVEY**  
UNDER

Application No. 68296.. Permit No. 49264.....

IN NAME OF

.....BAILEY NURSERIES, INC.....

Surveyed Sept. 24, 1987, by B.W. BISHOP.....

7/15/89  
HUB  
41071-178-131D