




T 23 S., R. 12 W., W.M.

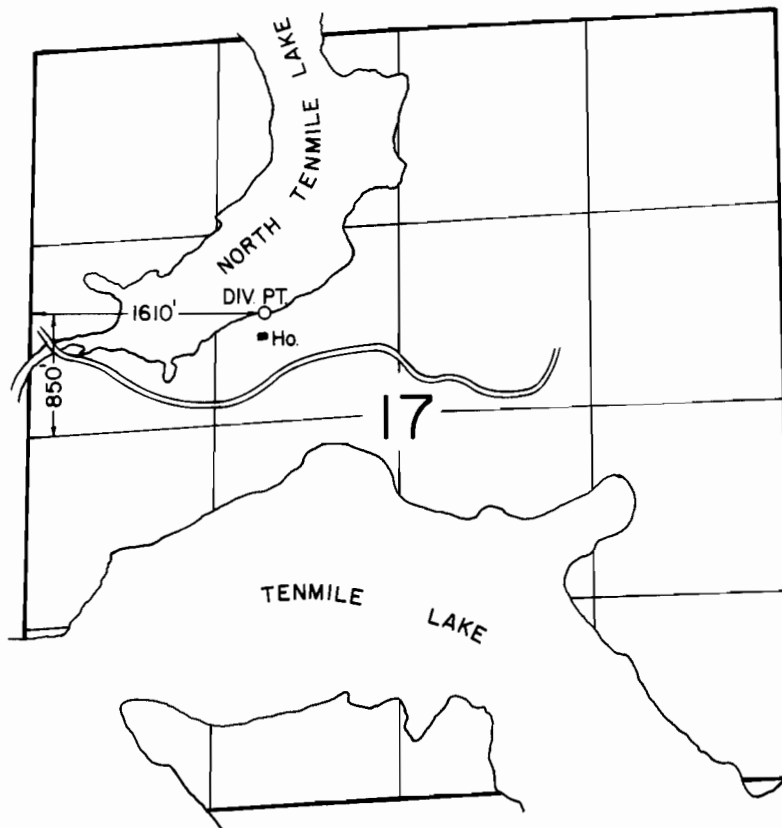

SCALE: 1" = 1320'

FINAL PROOF SURVEY
UNDER

Application No. 68375.. Permit No. 49453.....
IN NAME OF

JAMES B. KIRKMAN

Surveyed SEPT. 19.. 1988., by L. M. JOACHIMS