




T. 28 S., R. 12 W., W.M.

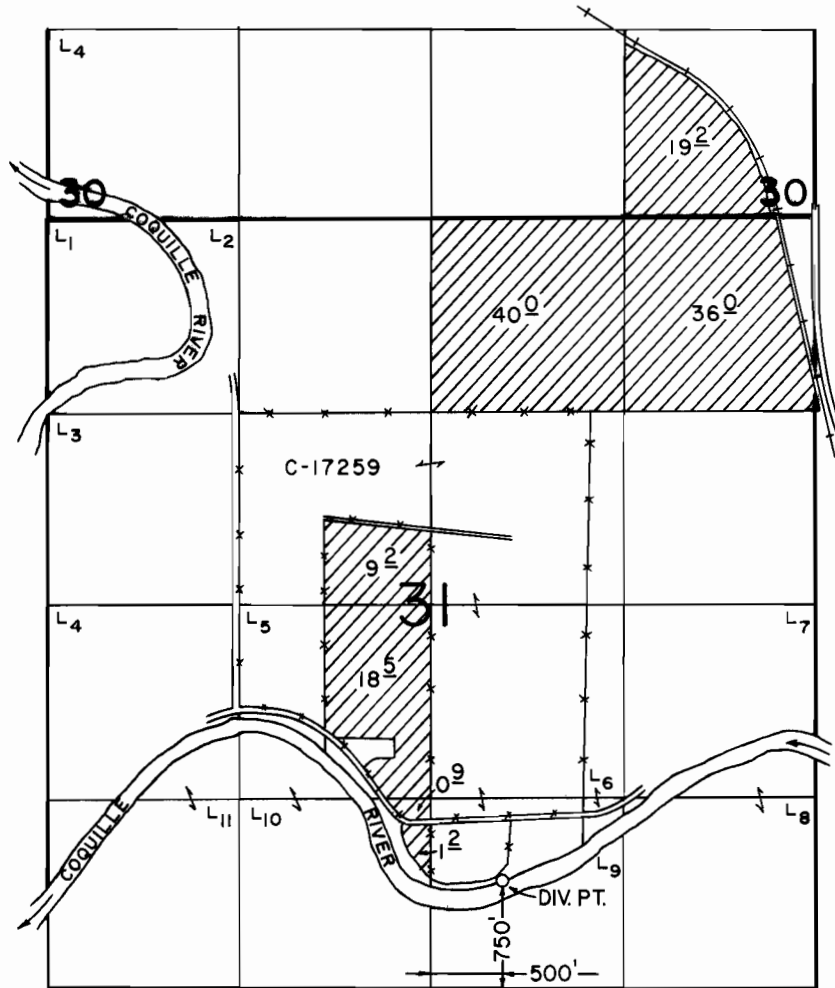

SCALE: 1" = 1320'

FINAL PROOF SURVEY
UNDER

Application No. 68793... Permit No. 49770...
IN NAME OF

ESTATE OF DON R. SCHMIDT...

Surveyed SEPT. 20 1988., by V. L. CHURCH...