




T.28 S., R.12 W., W.M.

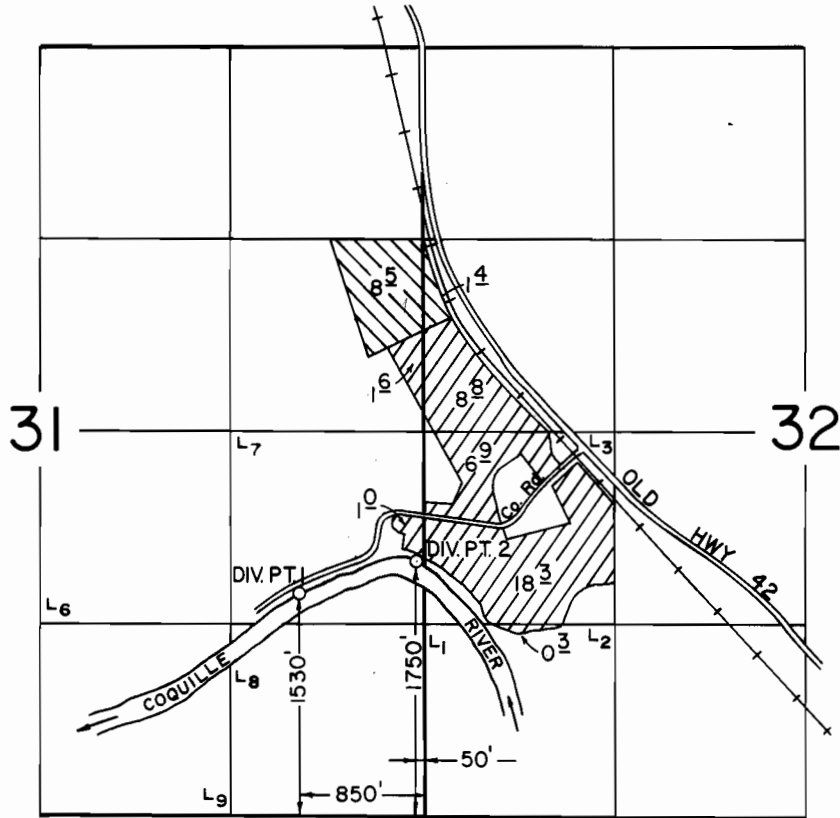

SCALE: 1" = 1320'

 DIV. PT. 1
 DIV. PT. 2

FINAL PROOF SURVEY
UNDER

Application No. 68797. Permit No. 49771.....
IN NAME OF

ERNEST E. ALLEN

Surveyed SEPT. 20 1989., by V. L. CHURCH.....