


T.3 S. R.7 E. W.M.

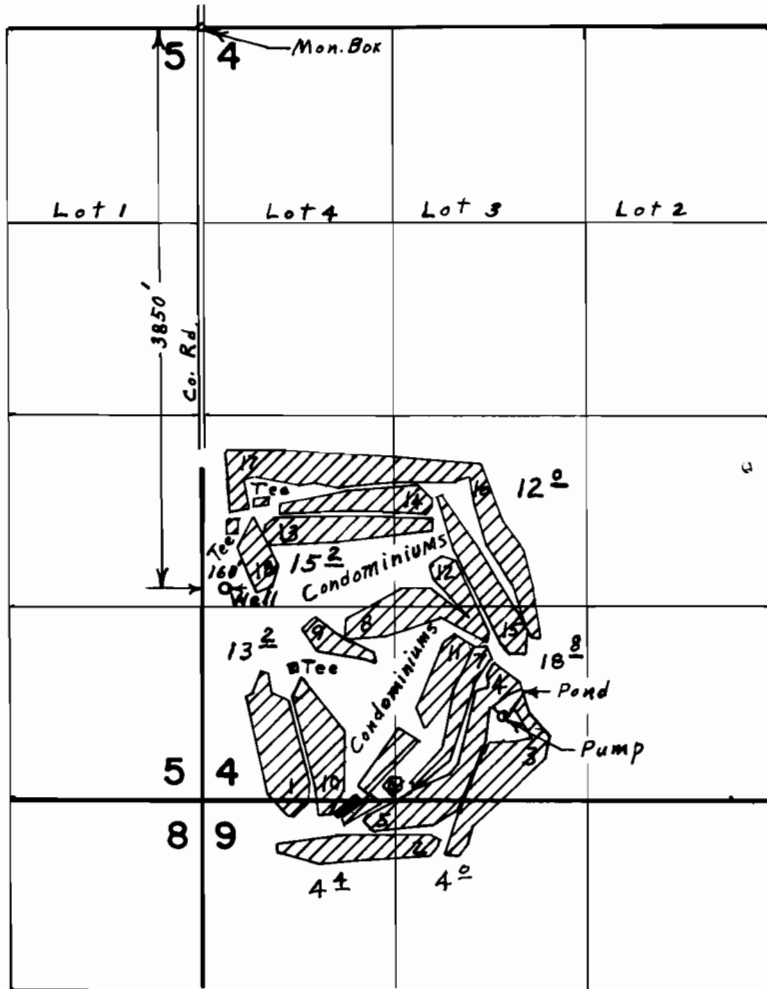

FINAL PROOF SURVEY UNDER

Application No. 9-3960 Permit No. 9-3714
IN NAME OF

EUGENE BOWMAN

Surveyed Oct. 14, 1976, by L. E. Gould