T.1N., R.3W., W.M.

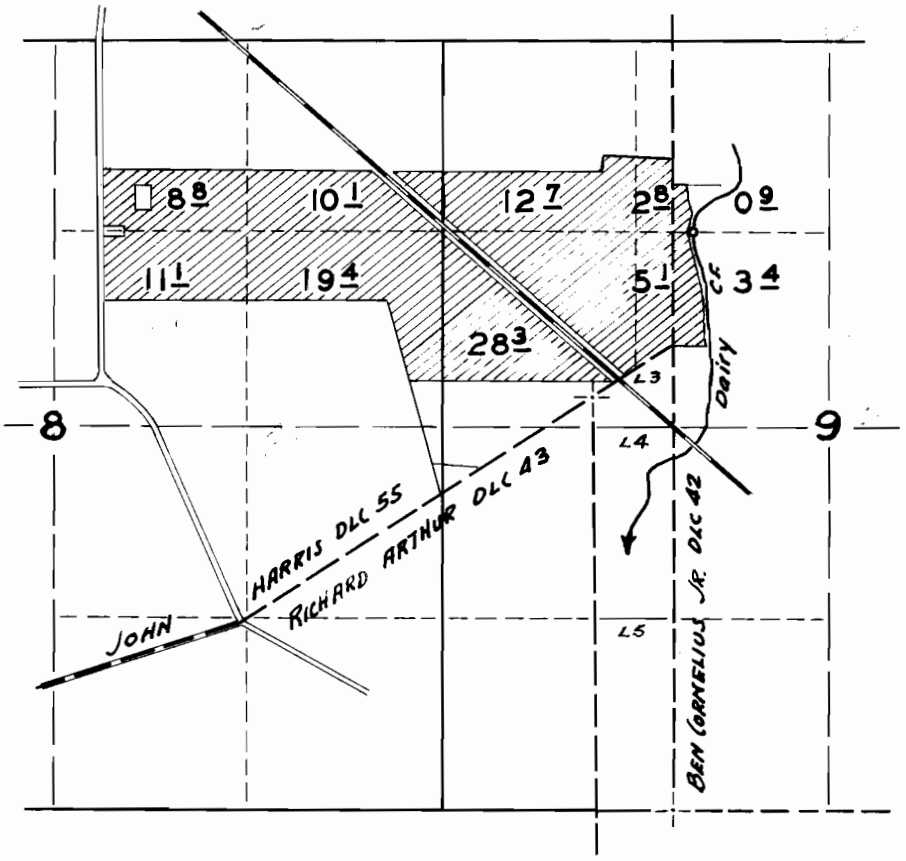

FINAL PROOF SURVEY

UNDER

Application No. 24511 Permit No. 19304

IN NAME OF

CHARLES F. HERINCKX

Surveyed 4 – 18 1956, by R.H. WHITBY

DFR -5D-03 WC