


T.8S.R.6W.W.M.

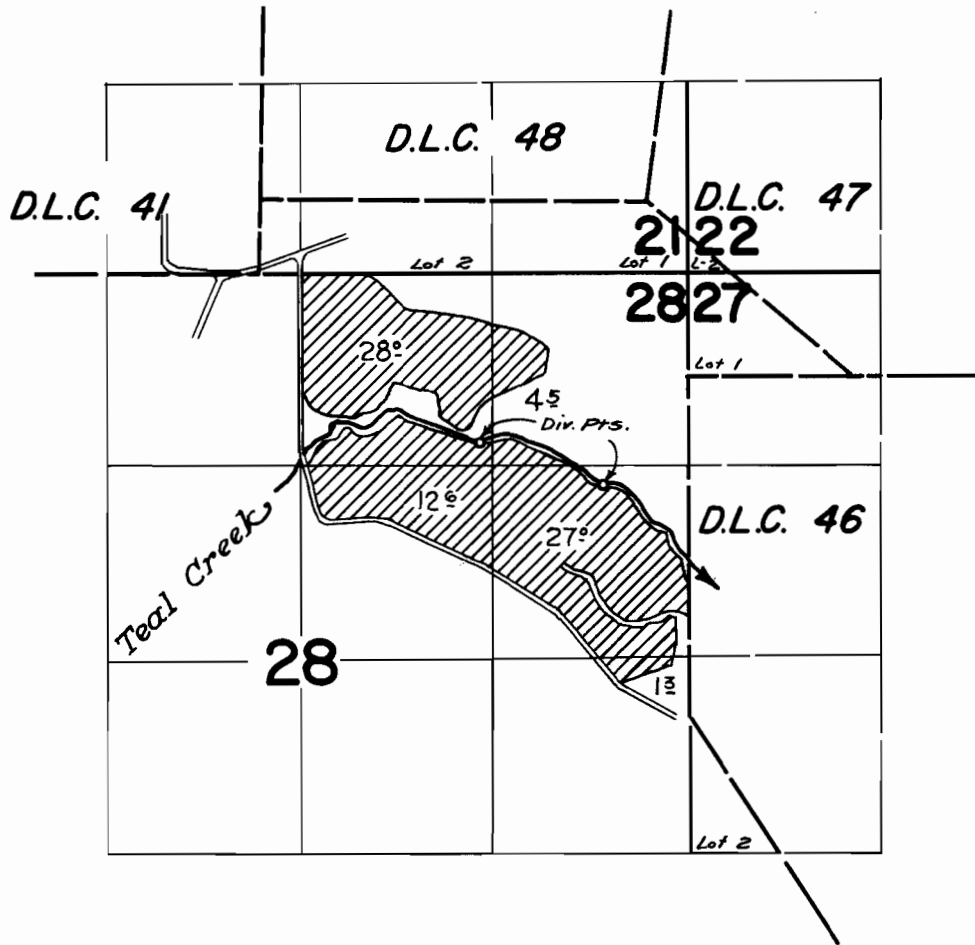

**FINAL PROOF SURVEY**  
UNDER

Application No. **31271** Permit No. **24636**  
IN NAME OF

**JOHN DORAN**

Surveyed August 31 1962., by Carl R. Baker.

RJ