


T.38S.R.35E.W.M.

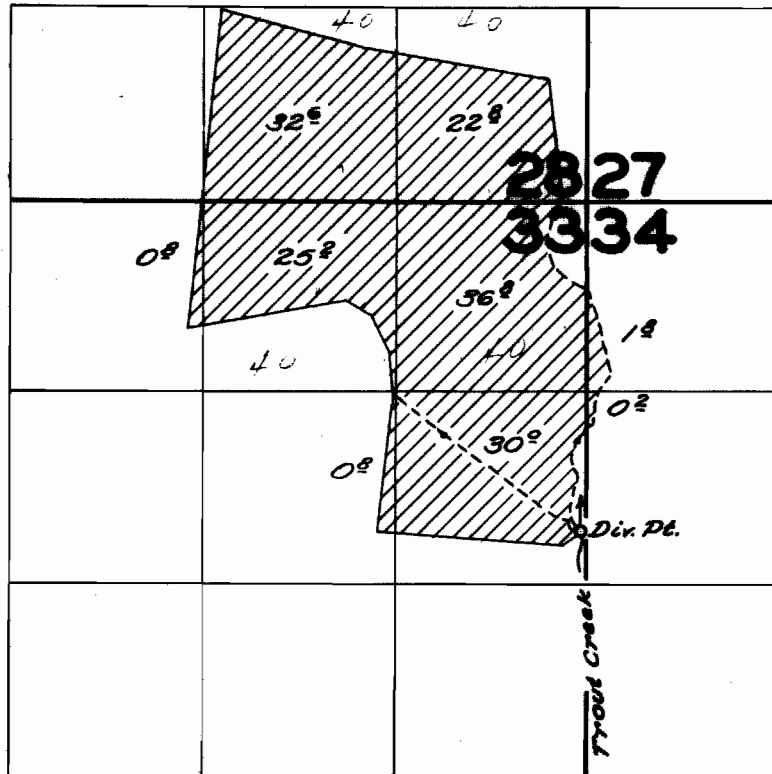

FINAL PROOF SURVEY UNDER

Application No. *S-43* Permit No.
IN NAME OF

.....
Surveyed *July 27, 1958*, by *C.D. Smith*.....