


T.39S. R.35-36E.W.M.

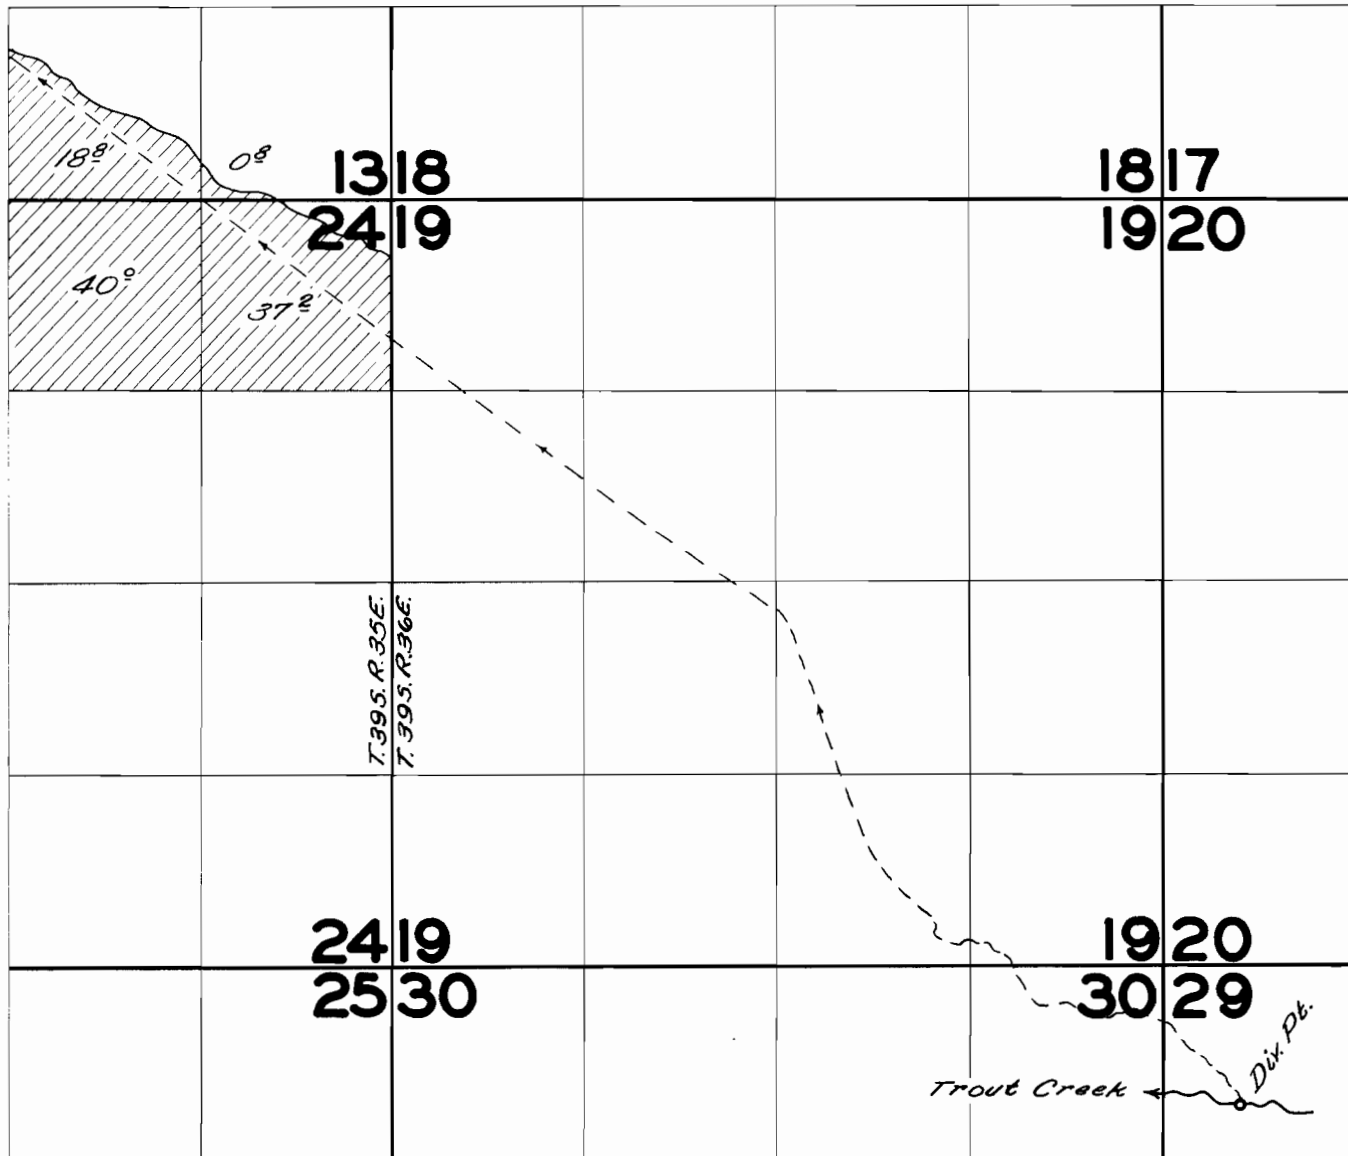

FINAL PROOF SURVEY UNDER

Application No. *5-43* ... Permit No.
IN NAME OF

Surveyed *July 27, 1958*, by *C.O. Bartels*