

T. 5 S. R. 4 W. W.M.

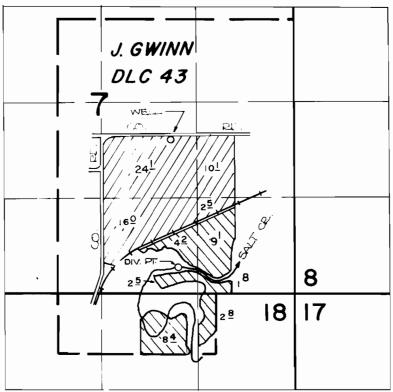

THE WELL IS LOCATED 2140 N. AND 1710 W., AND THE DIVERSION POINT IS LOCATED 350 N. AND 1600 W., BOTH FROM THE S.E. CORNER OF SECTION 7.

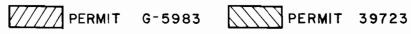

FINAL PROOF SURVEY

UNDER

	G-6394		G-5983
Application No.	52771	Permit No.	39723
IN NAME OF			
HANS E NADLER			
Surveyed OCT.	<u>6 19.83</u>	., by .₽.₽¤	vaters