# T. 5 S. R. 4 W. W.M.

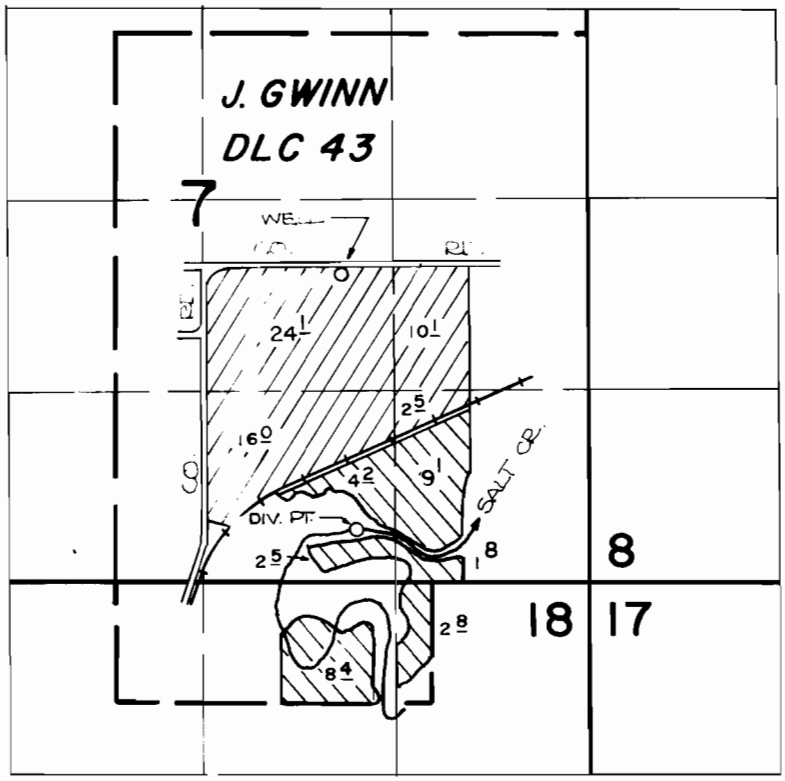


THE WELL IS LOCATED 2140' N. AND 1710' W., AND THE DIVERSION POINT IS LOCATED 350' N. AND 1600' W., BOTH FROM THE S.E. CORNER OF SECTION 7.

PERMIT G-5983 PERMIT 39723

## FINAL PROOF SURVEY

UNDER

Application No. G-6394 52771 Permit No. G-5983 39723

IN NAME OF

HANS E. NADLER

Surveyed OCT. 6 1983, by P. Pagter

DFQ-111-108 QUAD PRP 12/27/83