



T2S, R2W, WM

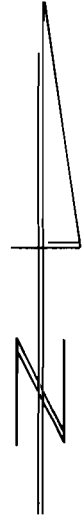

SCALE:
1" = 1320'

FINAL PROOF SURVEY
UNDER

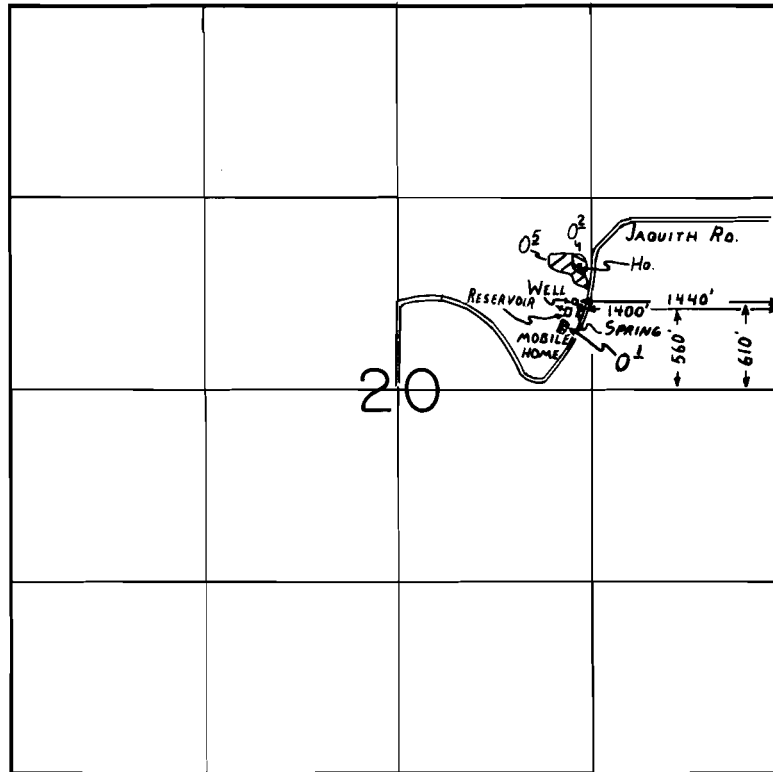

G-7154
PRIMARY IRR.



G-7154
SUPPLEMENTAL IRR.

R-53626 R-6426
53627 40329
Application No. G-7677 Permit No. G-7154

IN NAME OF
DONALD LEE HAYNES
ESTATE OF CHARLES A. HAYNES & SYLVIA M. HAYNES

Surveyed JUNE 30, 1988, by T. M. WARREN