
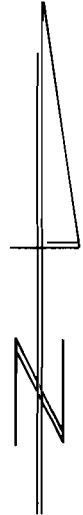


T2S, R2W, WM

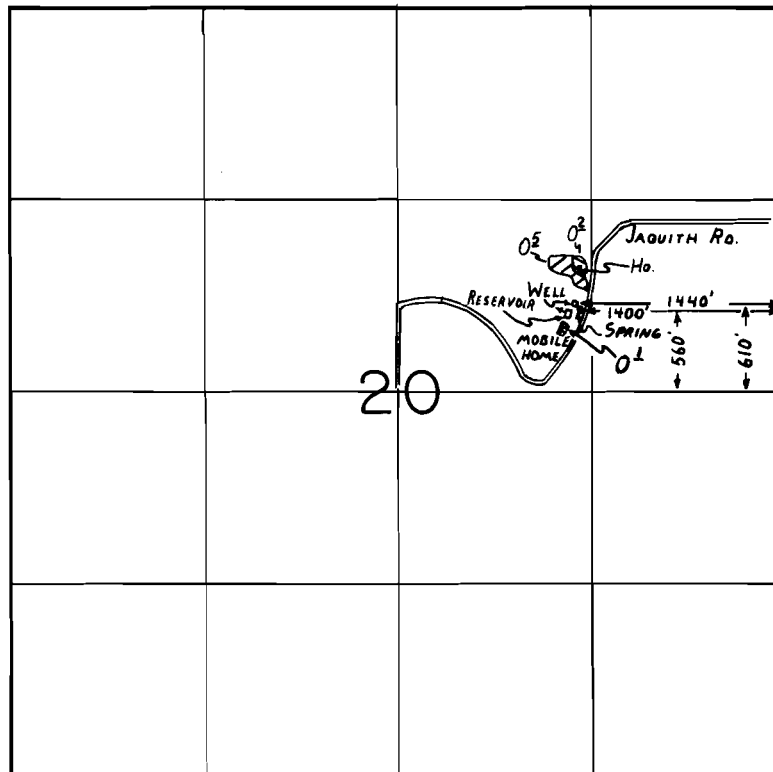

SCALE:

1" = 1320'

FINAL PROOF SURVEY

UNDER

G-7154
PRIMARY IRR.G-7154
SUPPLEMENTAL IRR.R-53626
53627R-6426
40329

Application No. G-7677... Permit No. G-7154.....

IN NAME OF

DONALD LEE HAYNES

ESTATE OF CHARLES A. HAYNES & SYLVIA M. HAYNES

Surveyed JUNE 30, 1988, by T. M. WARREN...

RWK
41067 178 1640