


T. 283S., R. 38E., W.M.

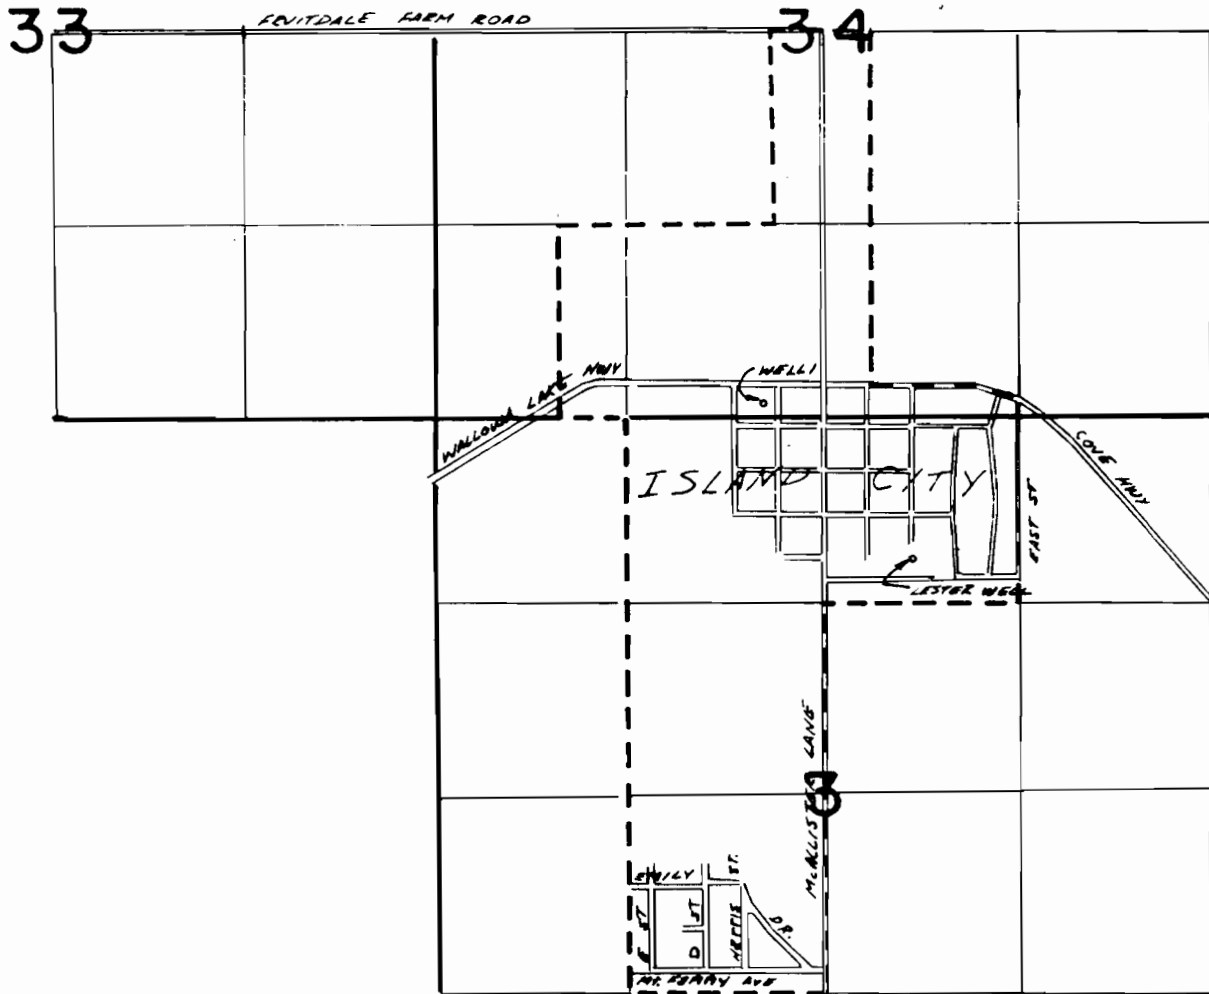

WELL 1 LOCATED 90' N. & 2240' E. FROM SW COR. SEC. 34, T. 25. R. 38E. W.M.
LESTER WELL LOCATED 970' S. & 2050' W. FROM NE. COR. SEC 3, T. 35. R. 38E. W.M.

FINAL PROOF SURVEY
UNDER

Application No. **G-7822** Permit No. **G-7224**
IN NAME OF

ISLAND CITY

Surveyed *Nov. 19* 1981, by *V.L. Church*