


T. 5S., R. 4W., W. M.

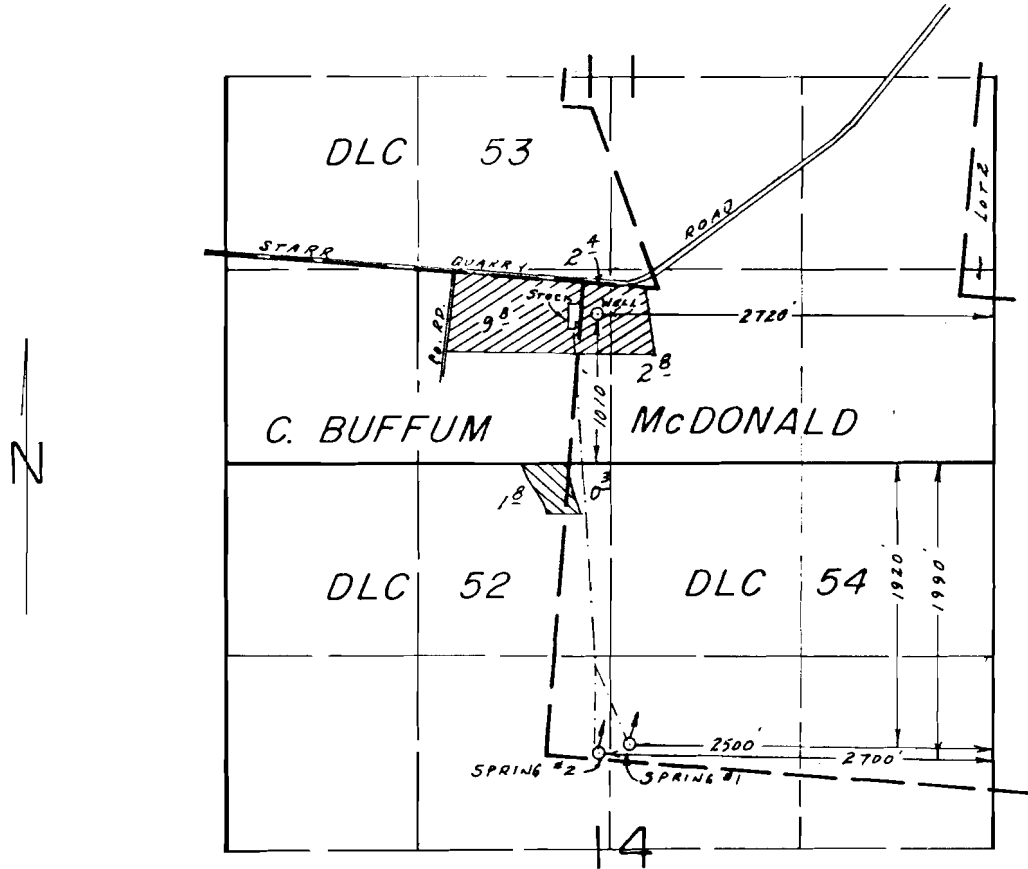

SCALE: 1" = 1320'

**FINAL PROOF SURVEY**  
UNDER

G-8290                      G-7667      
Application No. 57020... Permit No. 43298... 

IN NAME OF

JAMES E. & BETTI VAYNE DIONNE

Surveyed Aug. 22, 1984, by P. PAGTER.....  
Oct. 12, 1987, B.W. BISHOP

3/7/89  
pub  
A1071-178-LRR