


T. 5 S., R. 4 W., W. M.

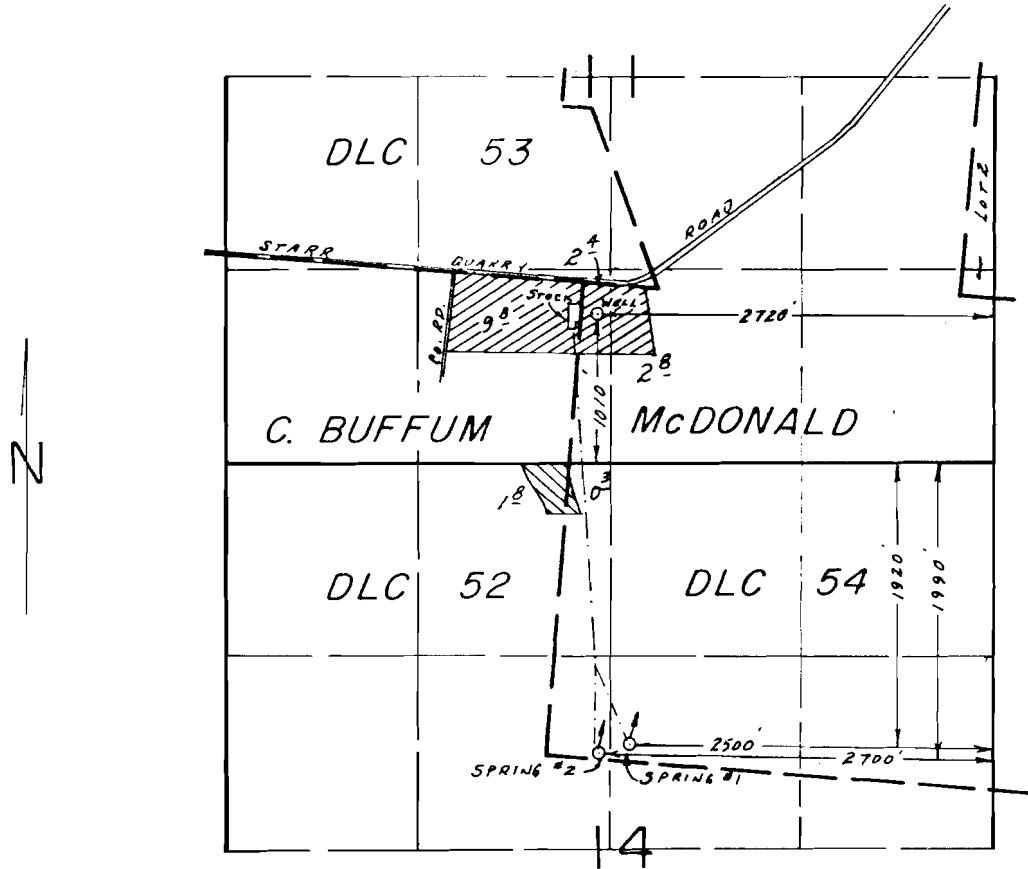

SCALE: 1" = 1320'

FINAL PROOF SURVEY
UNDER

G-8290 G-7667 
Application No. 57020... Permit No. 43298... 

IN NAME OF

JAMES E. & BETTI VAYNE DIONNE

Surveyed Aug. 22, 1984, by P. PAGTER.....
Oct. 12, 1987, B.W. BISHOP

3/7/89
pub
A1071-17R-LRR