


T. 9 S., R. 3 W., W.M.

Sec. 14

SE<sup>4</sup> SE<sup>4</sup>

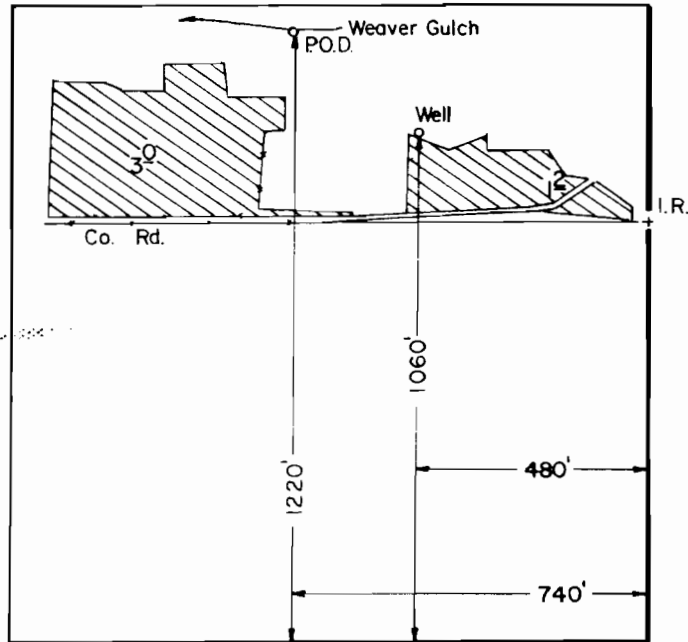

Scale: 1" = 400'

**FINAL PROOF SURVEY**  
UNDER

G-10399                      G-9371  
Application No. 61830    Permit No. 45834

IN NAME OF

**E. DAVID & JUDY K. KLEIN**

Surveyed May 6, 1986, by T. Warren