


T. 9 S., R. 3 W., W.M.

Sec. 14

SE ⁴ SE ⁴

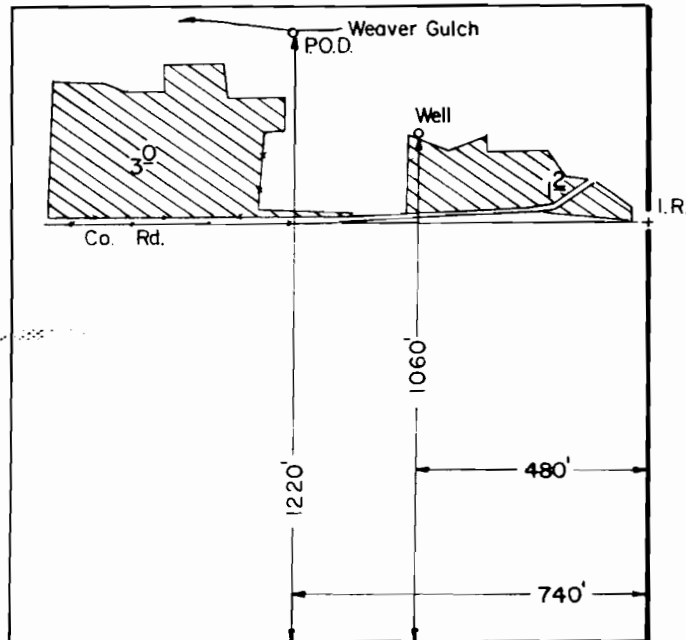

Scale: 1" = 400'

FINAL PROOF SURVEY UNDER

G-10399 G-9371
Application No. 61830... Permit No. 45834....
IN NAME OF

..... E. DAVID & JUDY K. KLEIN

Surveyed May 6, 1986, by T. Warren.....