


T. 1 S. R. 13 E. W. M.

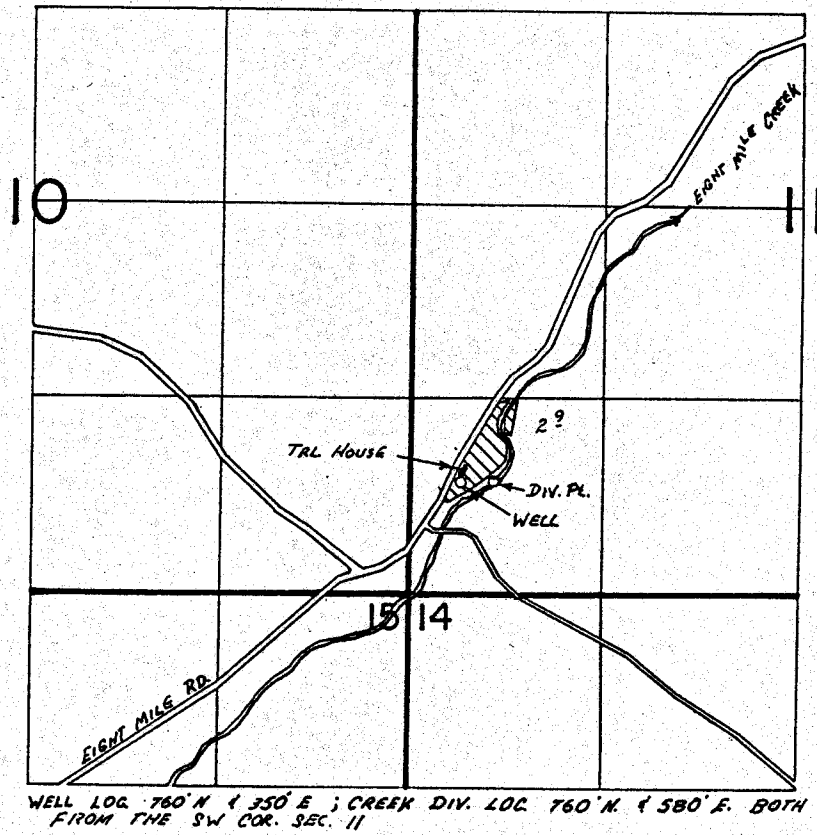

**FINAL PROOF SURVEY**  
UNDER

Application No. G-10452 61908 Permit No. G-9527 46303  
IN NAME OF

KENNETH L. FALK

Surveyed Oct. 15 1984, by T. Paul