


T. 26 S. R. 30 E. W.M.

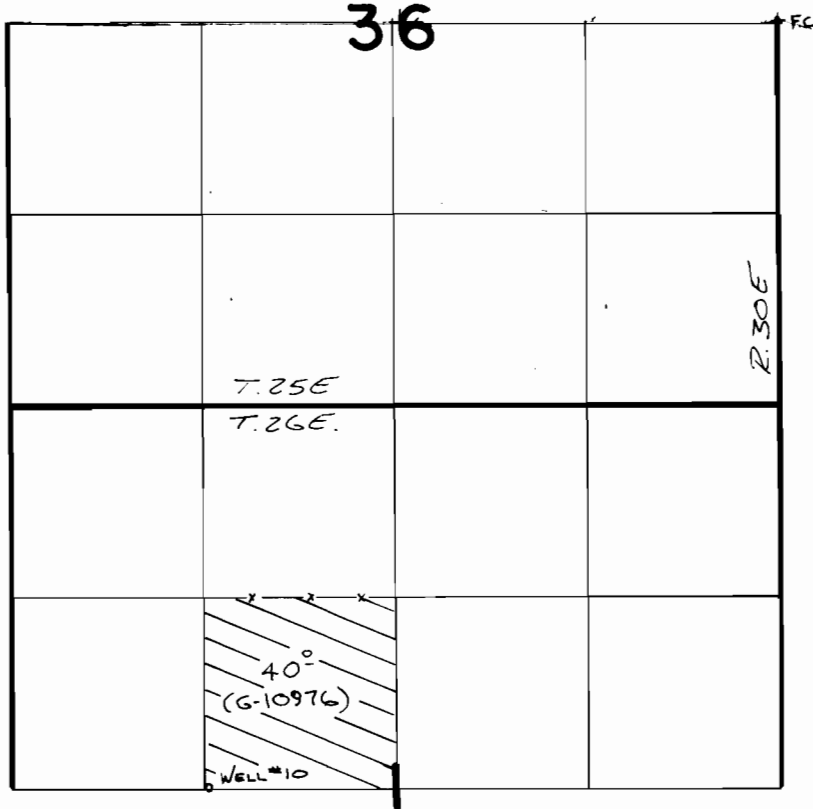

SCALE 1" = 1320'

WELL #10 LOC: 10' N. & 1340' E FROM W 1/4 COR. SEC 1 T26S., R. 30E.

**FINAL PROOF SURVEY**  
UNDER

Application No. **G-10976** Permit No. **G-10105**  
IN NAME OF

**GLEN CHOWNING**

Surveyed **5-6** 19**88**, by **T. WARREN**