


T. 3 S., R. 1 W., W. M.

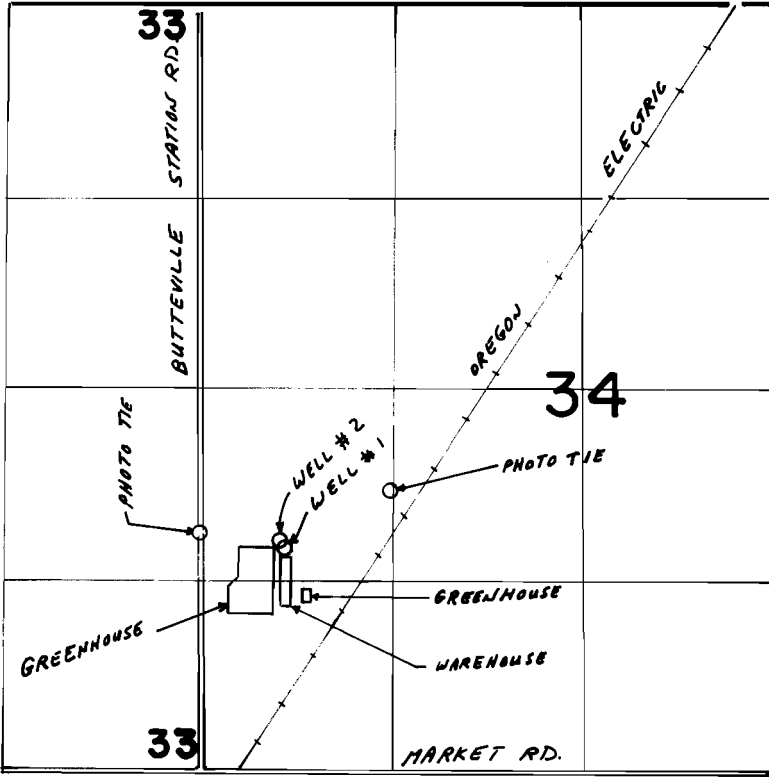

WELL 1 - 1520' N AND 550' E FROM SW CORNER SEC. 34
WELL 2 - 1580' N AND 540' E FROM SW CORNER SEC. 34



SCALE 1" = 1320'

FINAL PROOF SURVEY
UNDER

Application No. G-11345 Permit No. G-10482
IN NAME OF

CLACKAMAS GREENHOUSE, INC.

Surveyed APRIL 26 1988, by Z. SALEH

P.T.S., 41005-278-134D
5-19-89 Z.f.S.