


T. 8 S., R. 2 W., W. M.

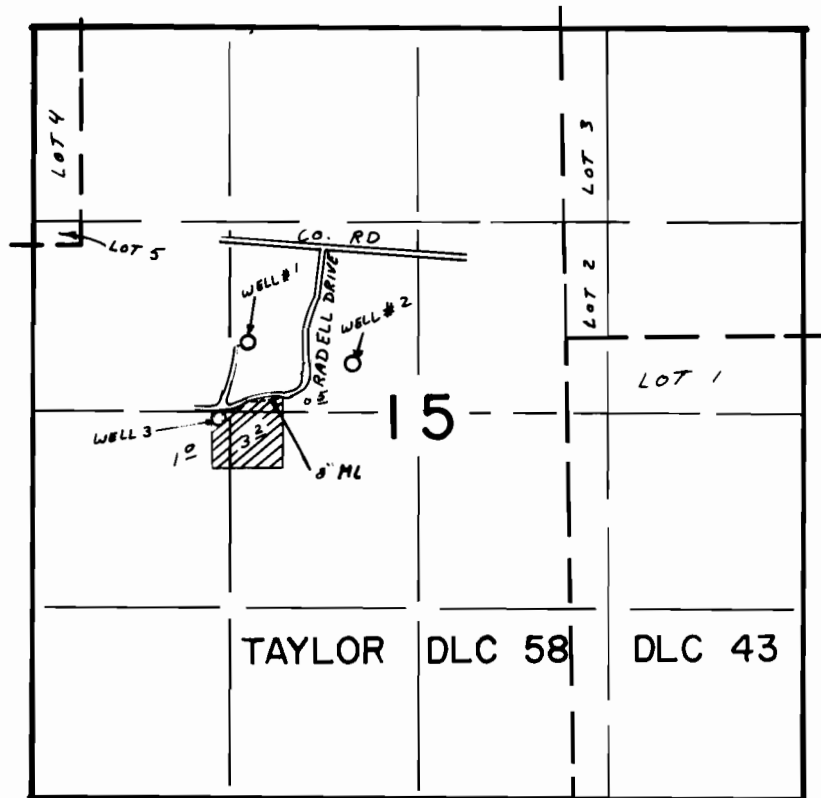

WELLS LOCATION: #1 - 50' S & 2250' W #2 - 200' S & 1500' W
#3 - 600' S & 2390' W ALL FROM NW CORNER DLC 43

N

SCALE 1" = 1320'

FINAL PROOF SURVEY UNDER

Application No. G-11614 Permit No. G-10691...
IN NAME OF

DELMER L. & LOIS M. BARBER

Surveyed JUL 7 1988, by Z. SALEH

41047-178-119L
1-5-89 Z.F.S.