
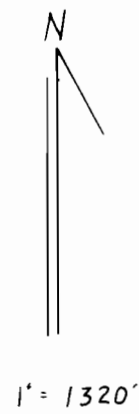


# T 8 S, R 6 W, WM

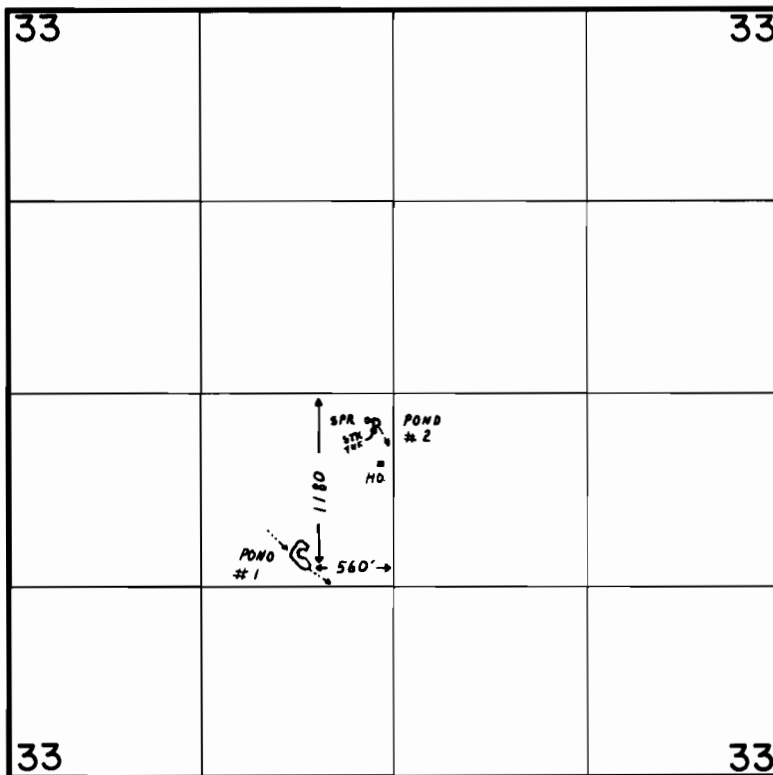

POND 2 IS LOCATED 220' SOUTH AND 100' WEST OF THE CEN 1/4 COR.  
 SPRING IS LOCATED 180' SOUTH AND 190' WEST OF THE CEN 1/4 COR.

## FINAL PROOF SURVEY UNDER

R-56817                      R-6770  
 Application No. 56818 Permit No. 42698.....  
 IN NAME OF

...G.W...or...NELLIE...J...KENDALL.....

Surveyed MAR. 22. 1988, by J.M. WARREN...