
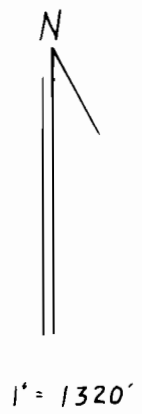


T 8S, R 6W, WM

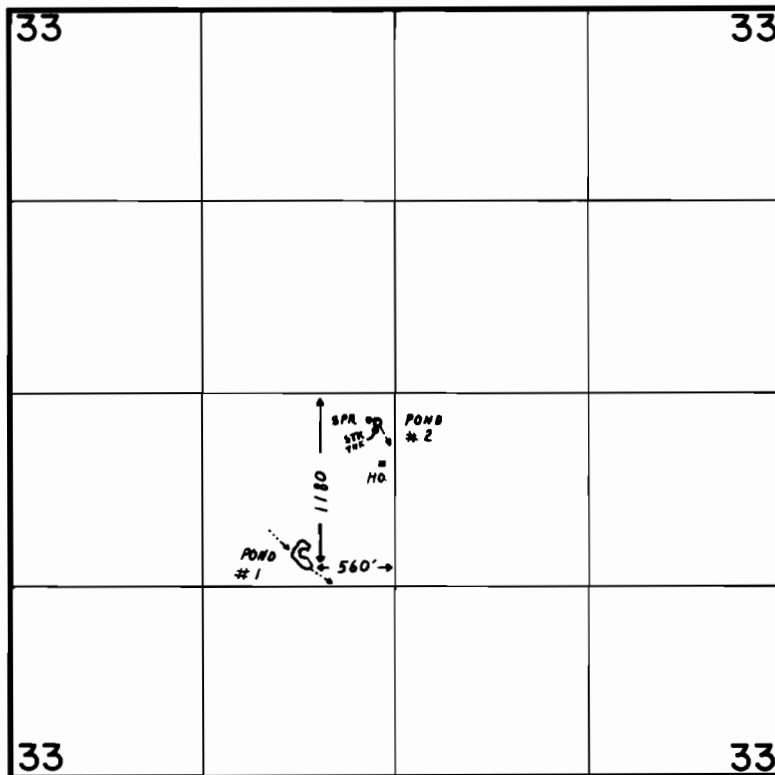

POND 2 IS LOCATED 220' SOUTH AND 100' WEST OF THE CEN. 1/4 COR.
 SPRING IS LOCATED 180' SOUTH AND 190' WEST OF THE CEN. 1/4 COR.

FINAL PROOF SURVEY UNDER

R-56817 R-6770
 Application No. 56818 Permit No. 42698.....
 IN NAME OF

...C.W...or...NELLIE...J...KENDALL.....

Surveyed MAR. 22. 1988, by J.M. WARREN...