


T. 10 S., R. 6 W., W. M.

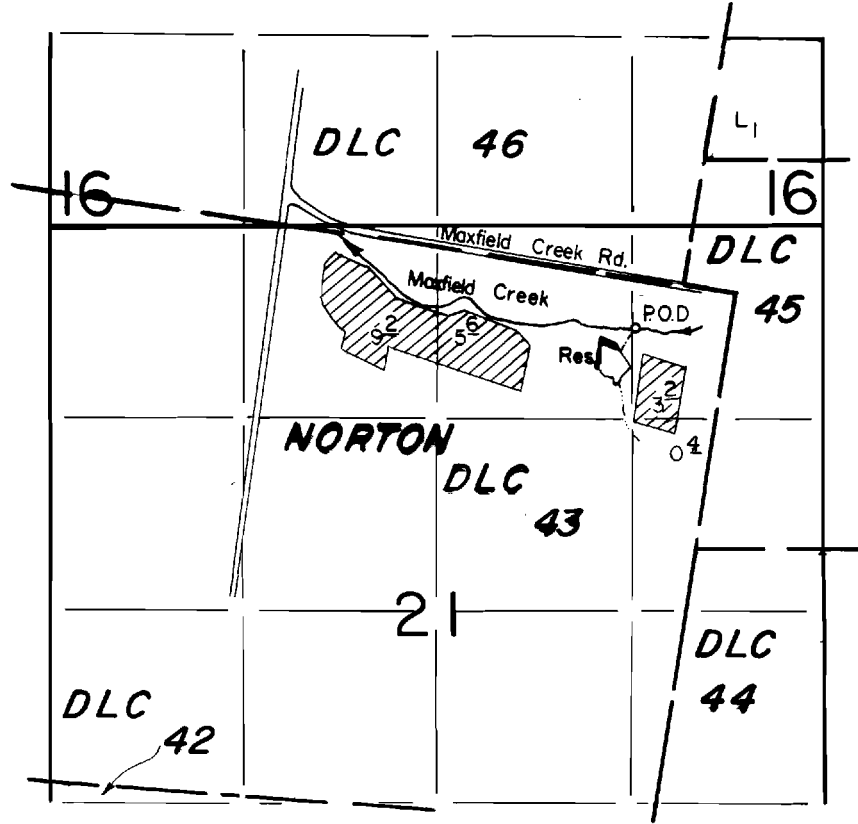

P.O.D. Loc. : 200' S. & 700' W. from NE Cor. DLC 44.
 RES. LOCs: - 350' S. & 900' W. from NE Cor. DLC 44

Scale: 1" = 1320'

FINAL PROOF SURVEY
 UNDER

R-58626 R-7929

Application No. 58627 Permit No. 44383

IN NAME OF

PATRICK M. MALONE

Surveyed April 28, 1987, by T. Warren