


T. 8 S., R. 6 W., W.M.

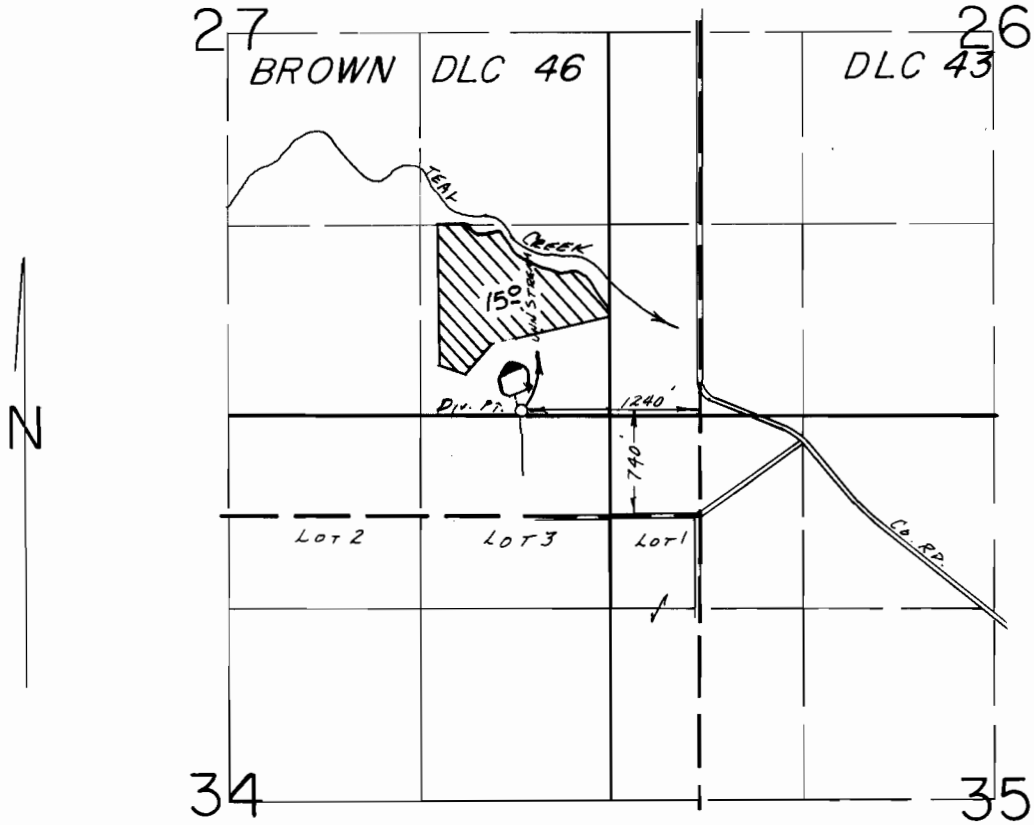

SCALE: 1" = 1320'

FINAL PROOF SURVEY
UNDER

63248 46708
Application No. R-63247 Permit No. R-8410...
IN NAME OF

..... DAVID ALLEN

Surveyed June 2, 1987, by B.W. BISHOP.....

3/24/89
BWB
PTS 19878