



T.8S.R.6W.W.M.

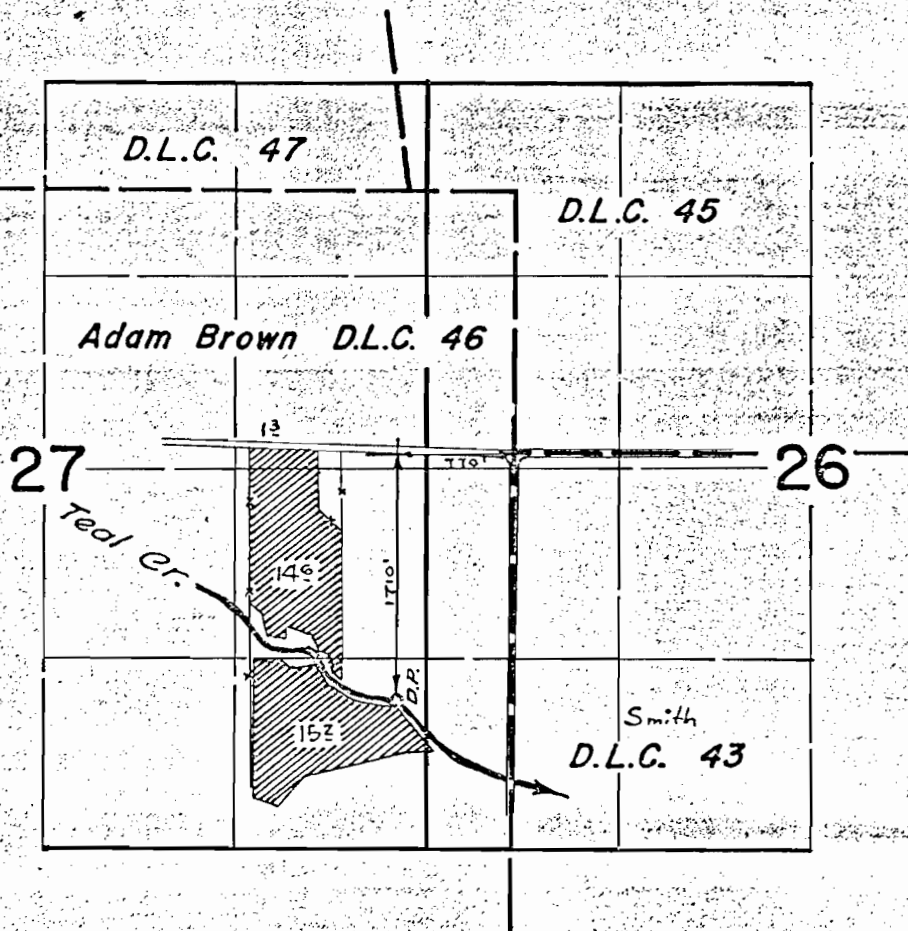

Application No. R-632474
63248
Permit No. R 8410
46708

RECEIVED
FEB 8 1982
WATER RESOURCES DEPT.
SALEM, OREGON

Sec. 27 T8S R6W
Scale 1"=400

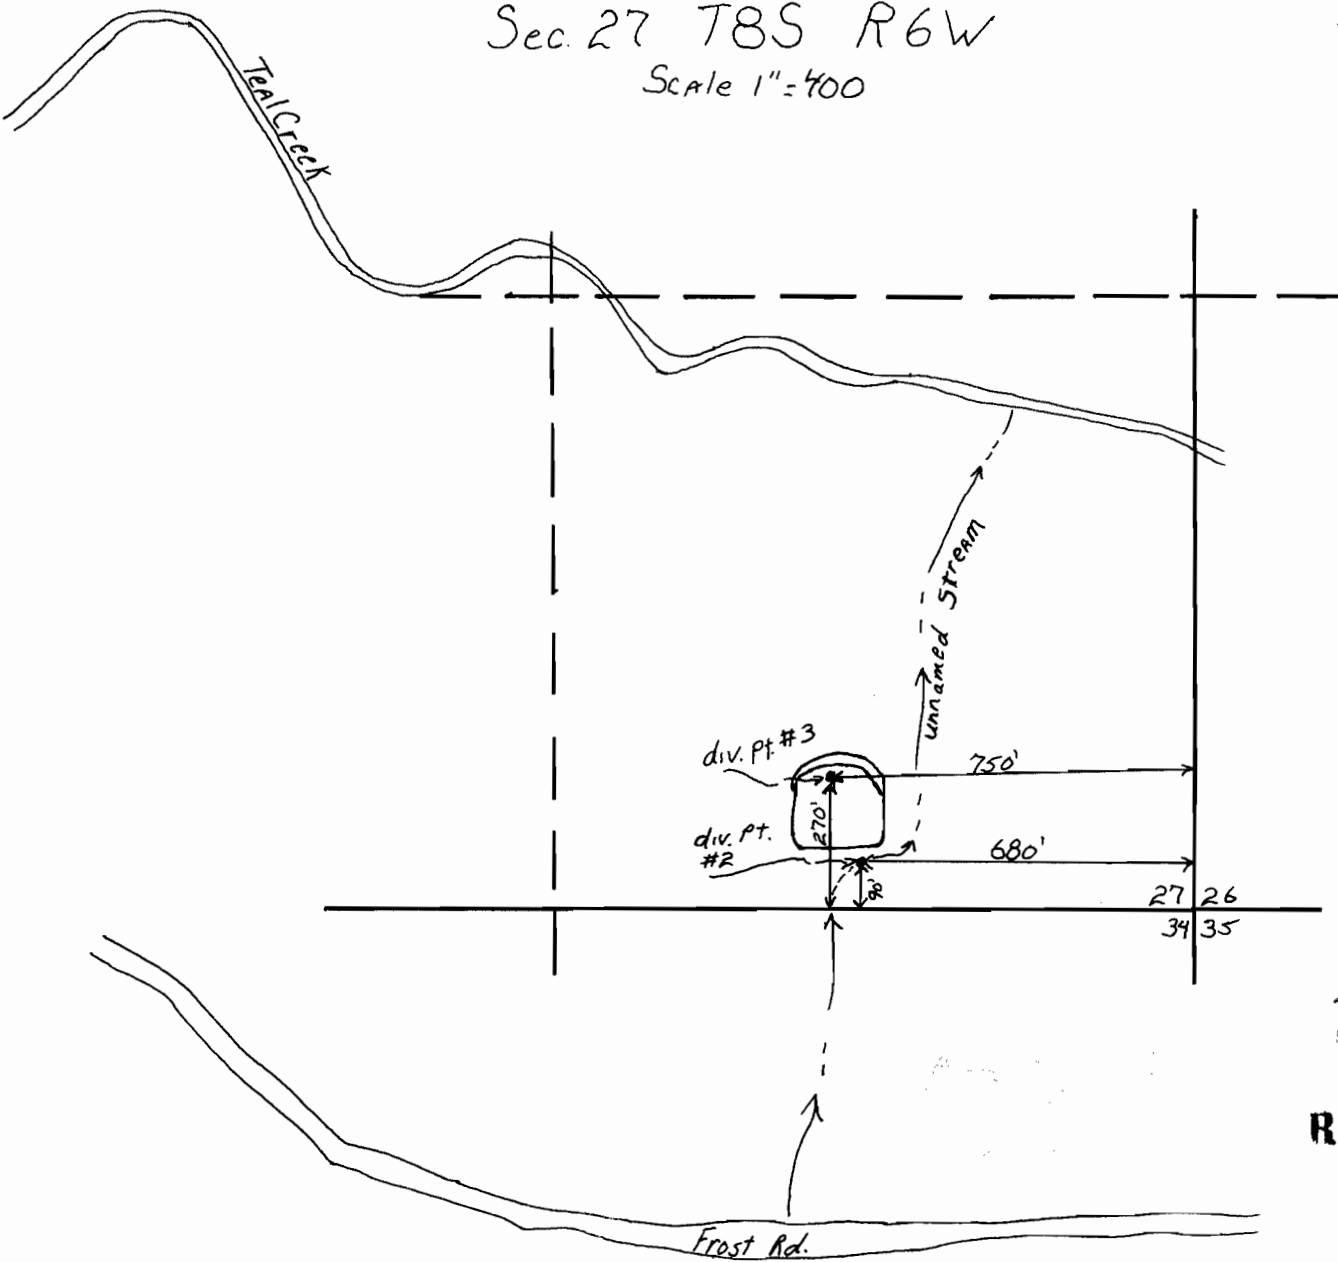

652414
65242
R 8410
46708

David Allen

Stock will drink
from pond

RECEIVED
FEB 8 1982
WATER RESOURCES DEPT.
SALEM, OREGON