
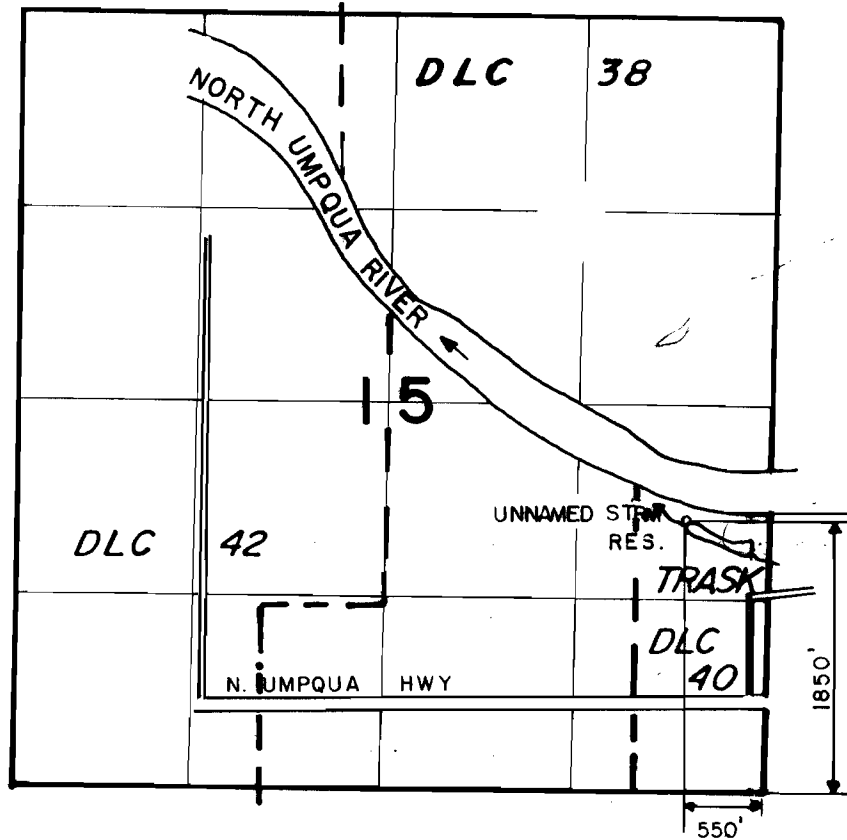


T. 26 S., R. 4 W., W.M.

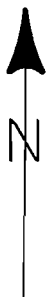

SCALE: 4" = 1 MILE

FINAL PROOF SURVEY
UNDER

R-68097 R-9972
Application No. 68142 Permit No. 48757
IN NAME OF

RICHARD CADDOCK

Surveyed SEPT. 28 1988, by J.M. SCHMORDE