


T. 3S., R. 46E., W. M.

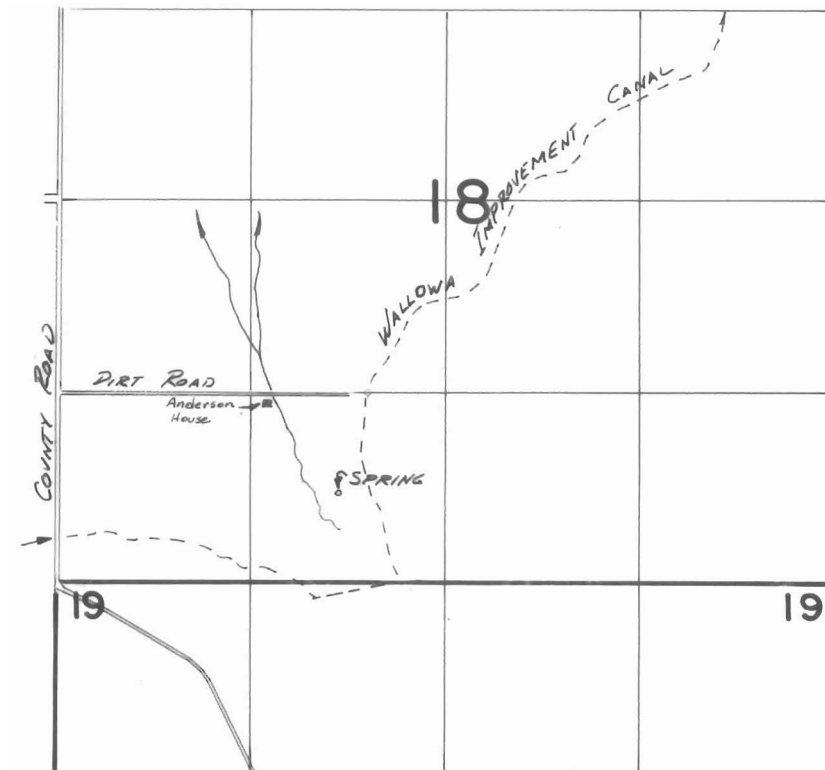

SPRING LOC: 610' N, 1930' E. FROM SW COR. SEC. 18

**FINAL PROOF SURVEY**  
UNDER

Application No. **49599** Permit No. **37166**  
IN NAME OF

Christine Anderson &  
Robert H. & Willa M. Eytchison

Surveyed Aug. 18, 1981, by V. L. Church, F. B. Estes.