


T.5S. R.1W. W.M.

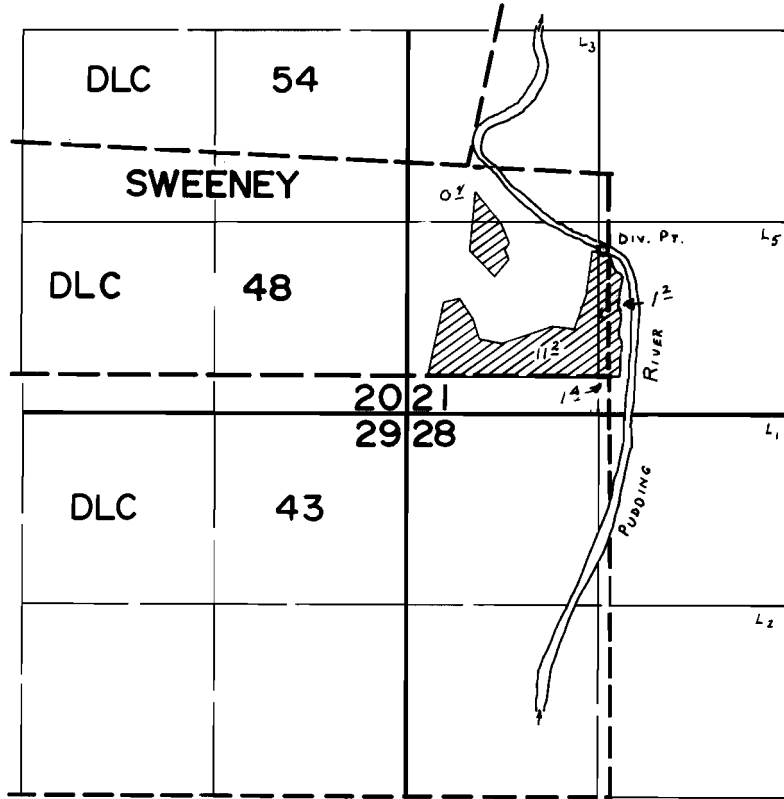

Div. Pt. Loc: 520' S 430' W fr. NE Corner, DLC 48

FINAL PROOF SURVEY UNDER

Application No. 49936.. Permit No. 37564.....

IN NAME OF

FRED GESCHWILL

Surveyed June 30, 1980, by C. L. Hughes.....