


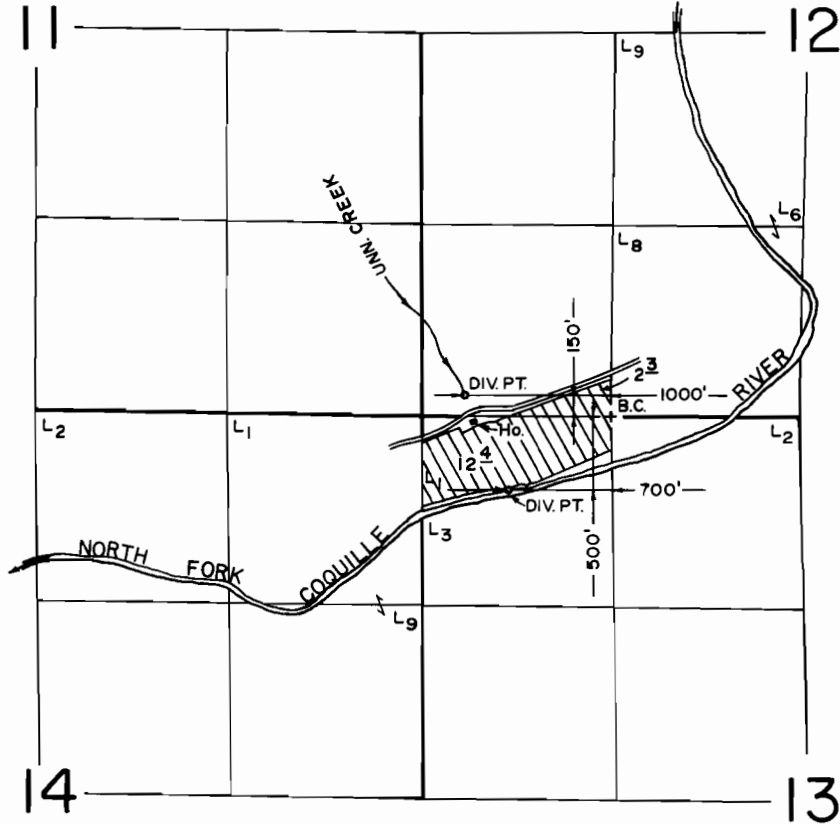

T. 28 S., R. 12 W., W.M.



SCALE: 1" = 1320'

**FINAL PROOF SURVEY**  
UNDER

Application No. 50248. Permit No. 37960.....  
IN NAME OF

C. S. & LENA ANDERSON, ANN & HOLLIS MAST

Surveyed SEPT. 20, 1988, by ...V.L. CHURCH...