


T.16S.,R.5W.,W.M.

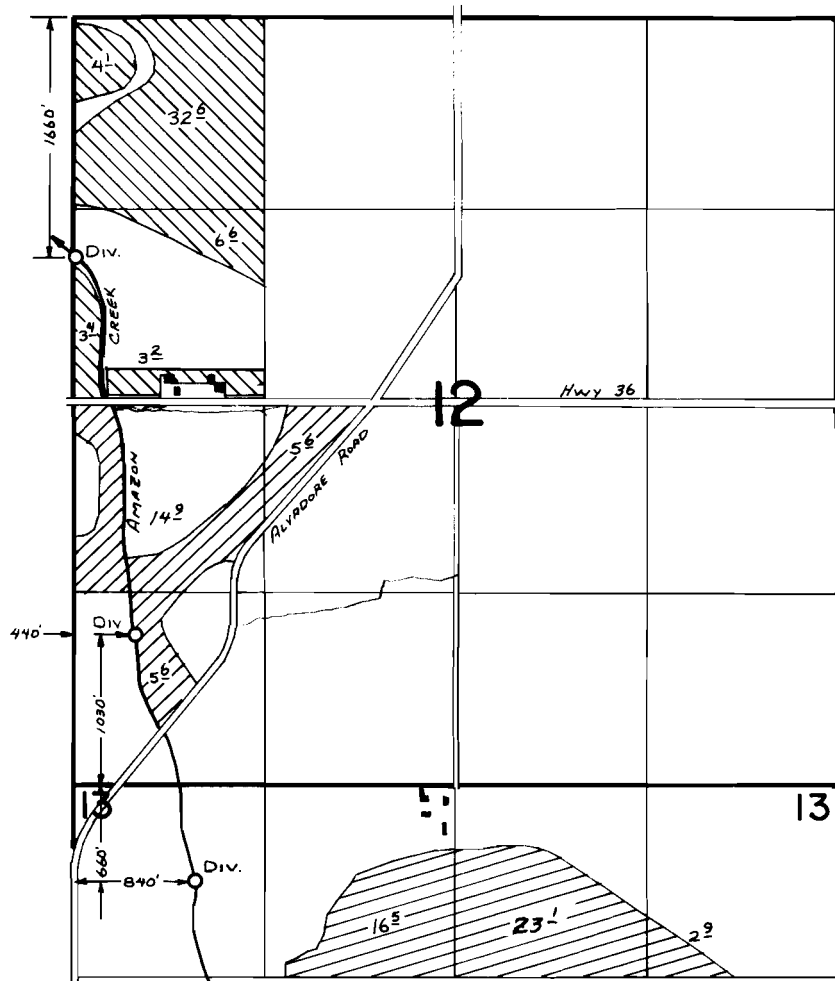

FINAL PROOF SURVEY

UNDER

55696

41719

55697

41720

Application No. 55698 Permit No. 41721

IN NAME OF

EVERETT FALK

Surveyed Sept. 17, 1981, by S.C. BROWN

