


T. 5 S., R. 4 W. WM.

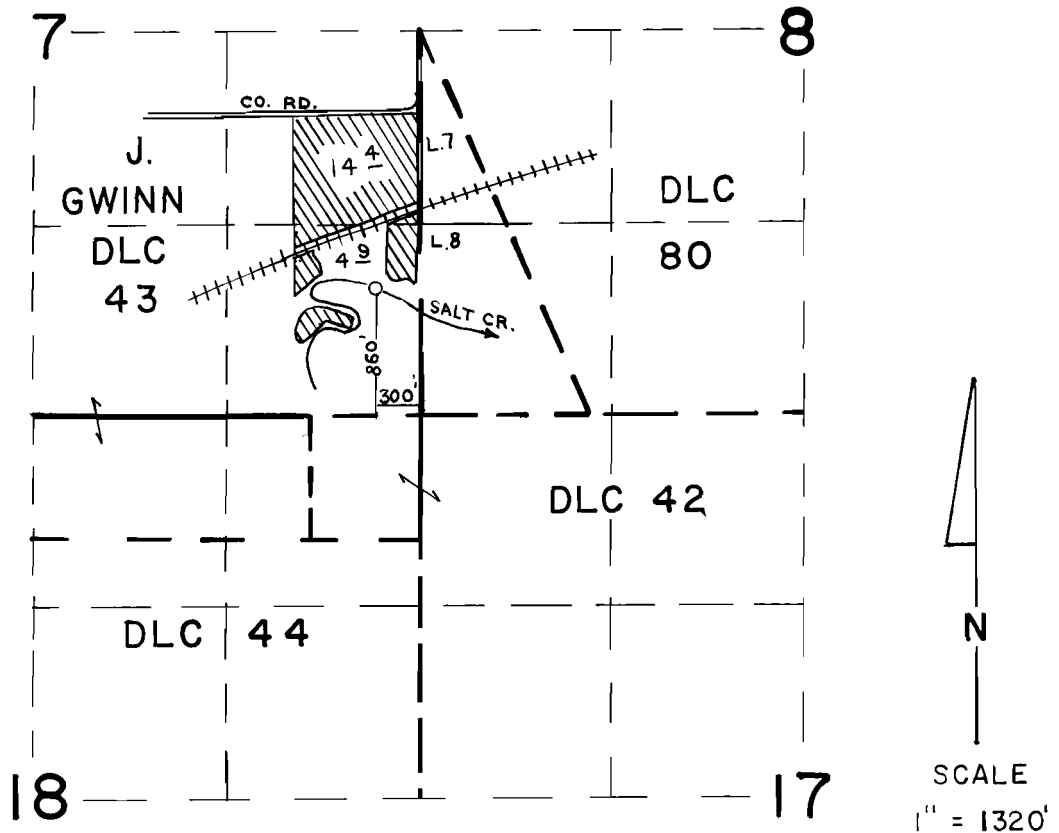

FINAL PROOF SURVEY
UNDER

Application No. 57117 Permit No. 42924
IN NAME OF

EDWARD L. THURSTON

Surveyed APR 25 1984, by P. PAGTER