


T. 37 & 38 S., R. 7 W., W. M.

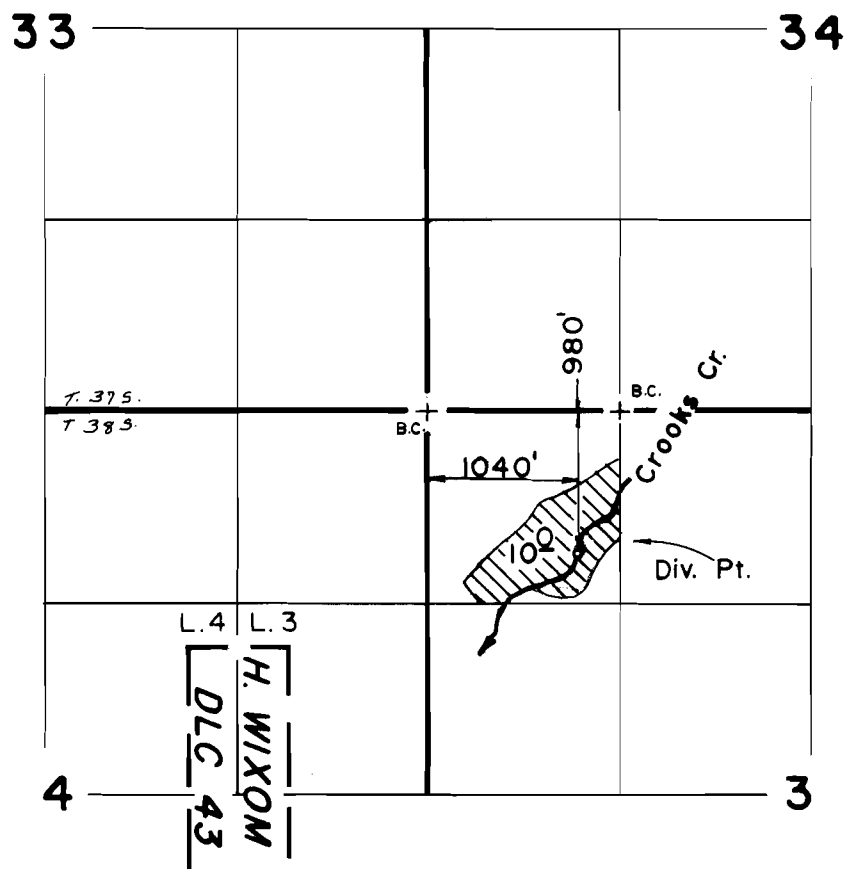

Scale: 1" = 1320'

FINAL PROOF SURVEY
UNDER

Application No. 57109... Permit No. 42953
IN NAME OF

EARL C. & GRACE R. STROHKIRCH

Surveyed JUN. 19. 1986, by B. S. JAMES.