


T. 38 S., R. 3 W., W. M.

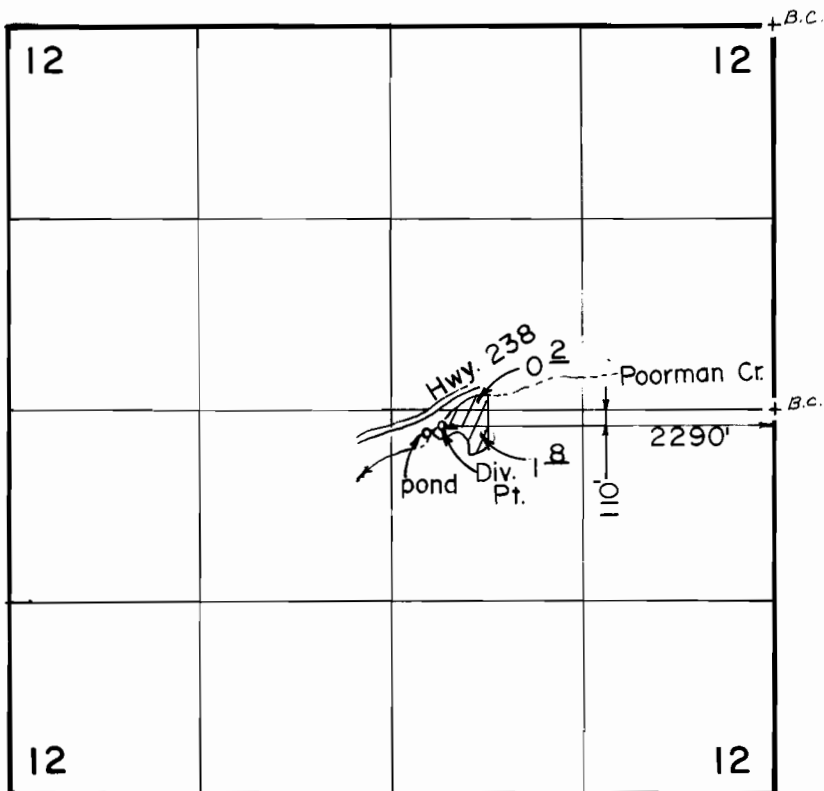

Scale: 1" = 1320'

FINAL PROOF SURVEY
UNDER

Application No. **57431** Permit No. **43266**
IN NAME OF

.....**JERRY M. & RENEE I. M. JOHNSON**.....

Surveyed **AUG. 10. 1988**, by **B. S. JAMES**...