


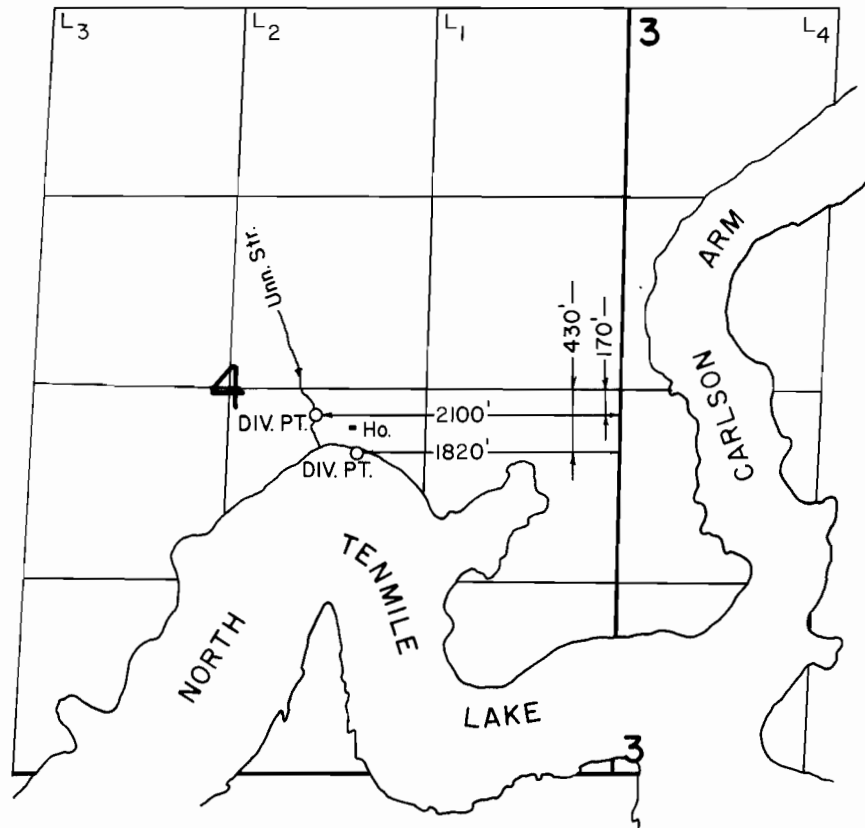

T. 23 S., R. 12 W., W.M.



SCALE: 1" = 1320'

FINAL PROOF SURVEY UNDER

Application No. 57460 Permit No. 43286
IN NAME OF

DENNIS S. JACOBSEN

Surveyed SEPT. 20 1988, by T. M. WARREN

4-21-89

41011-180-244 A

Joe