


T. 36S., R. 6 W., W.M.

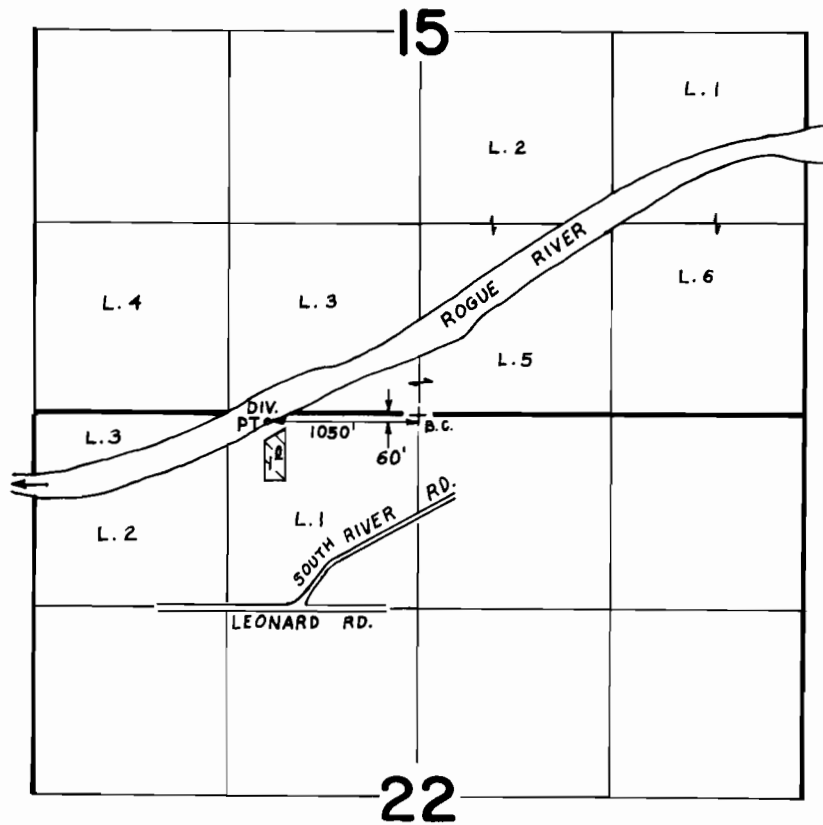

SCALE: 4" = 1 MILE

FINAL PROOF SURVEY
UNDER

Application No. 57643 Permit No. 43423
IN NAME OF

STEPHANIE R. MOFFETT

Surveyed JAN. 18 1984, by B. S. JAMES