


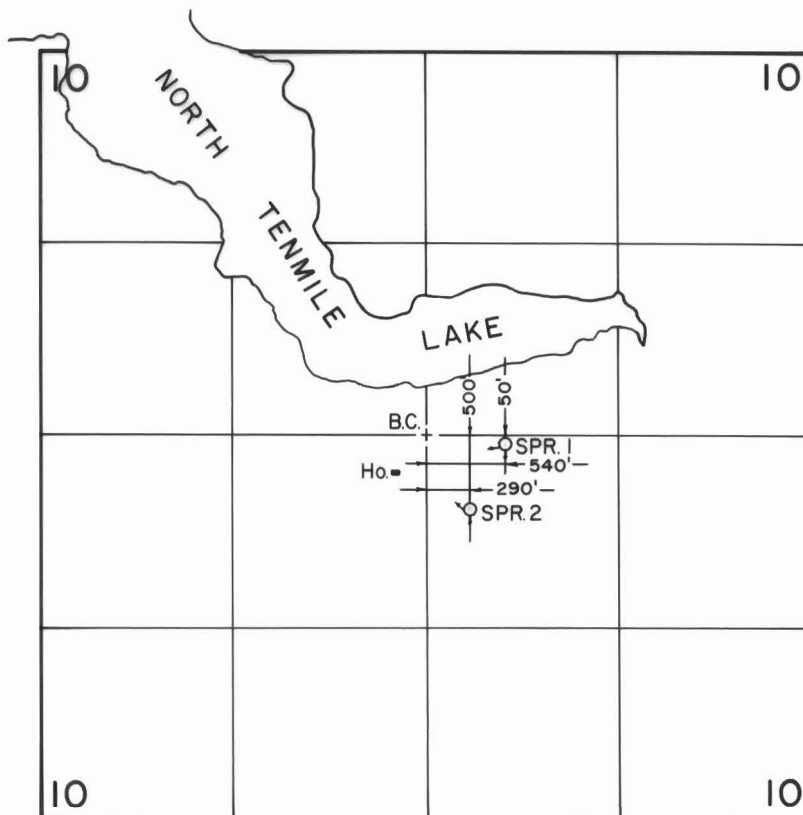

T. 23 S., R. 12 W., W.M.



SCALE: 1" = 1320'

FINAL PROOF SURVEY UNDER

57603

43433 (SPRING 1)

Application No. 60493 Permit No. 46787 (SPRING 2)
IN NAME OF

JOHN BOYD & MARY WILSON

Surveyed SEPT. 17, 1988, by T. M. WARREN.

4-17-89

41011-180-244 A

JCL