


T. 40 S., R. 14 W., W.M.

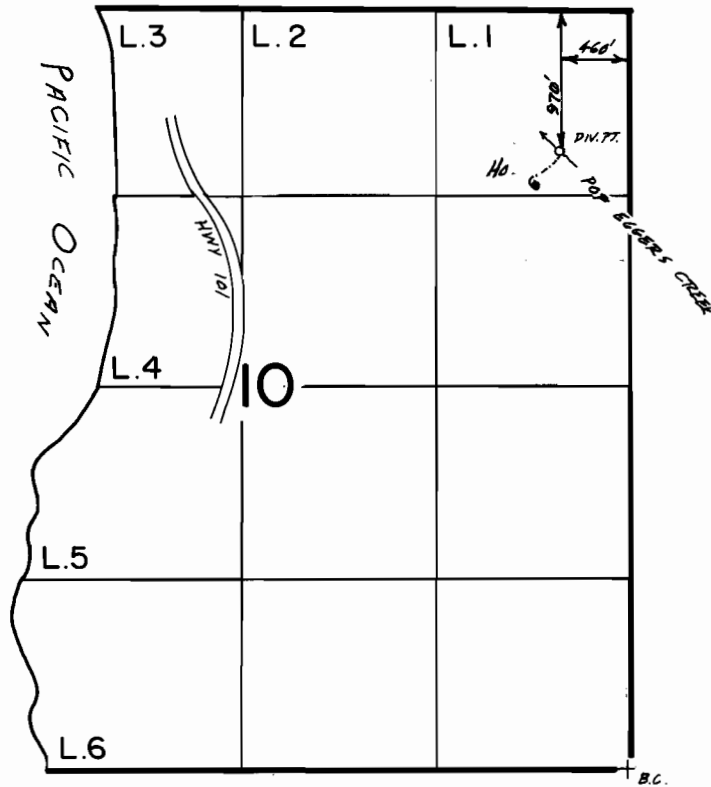

Scale 1" = 1320'

FINAL PROOF SURVEY

UNDER

Application No. 57937 Permit No. 43673...
IN NAME OF

ALBERT HERBERT MIRATI, Jr.

Surveyed Sept. 21, 1987, by J. KAUPPILA