


T. 27 S., R. 12 W., W.M.

SECTION 14

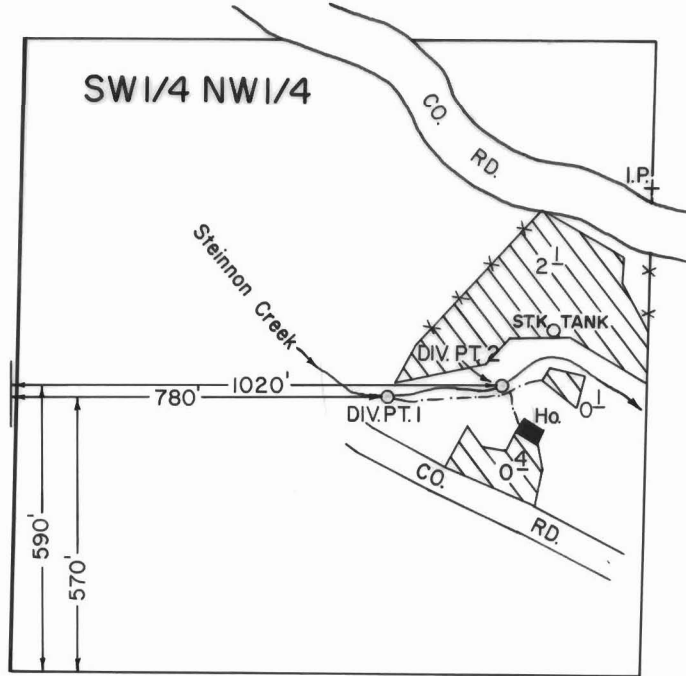

SCALE 1" = 400'

**FINAL PROOF SURVEY**  
UNDER

Application No. 58310... Permit No. 43911.....  
IN NAME OF

BENJAMIN DAVID MORRISON.....

Surveyed OCT. 11... 1983, by L. E. CASHION.....