


T. 37 S., R. 6 W., W.M.

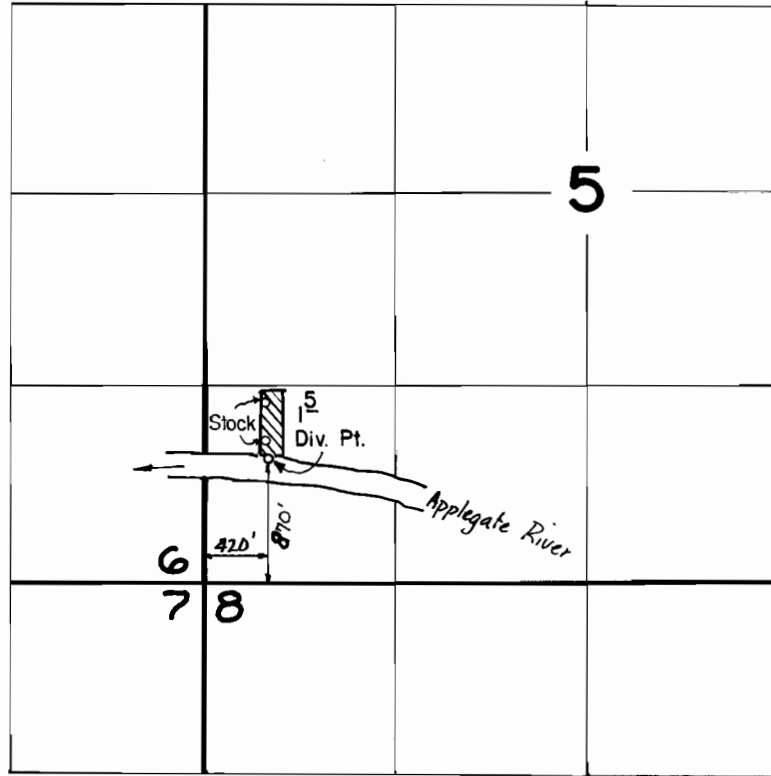

FINAL PROOF SURVEY
UNDER

Application No. 58418... Permit No. 44052...
IN NAME OF

..... **JOSEPH J. ORRIO**

Surveyed OCT. 18, 1983, by B. S. JAMES.....