


T.3S. R.4W. W.M.

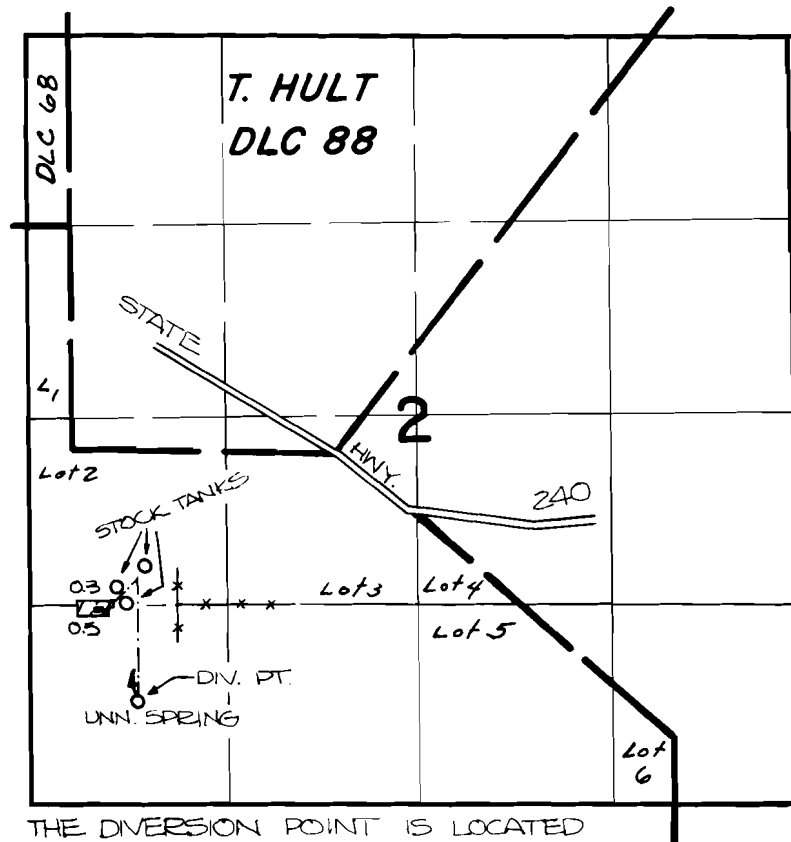

THE DIVERSION POINT IS LOCATED
1740' S. AND 460' E. FROM THE S.W.
CORNER OF DLC 88.

FINAL PROOF SURVEY UNDER

Application No. ~~58460~~... Permit No. ~~44094~~.....
IN NAME OF

.....PATRICIA A. & H.T. POWERS.....

Surveyed NOV. 10, 1983, by P.R. Patten.....