




T. 23 S., R. 12 W., W.M.

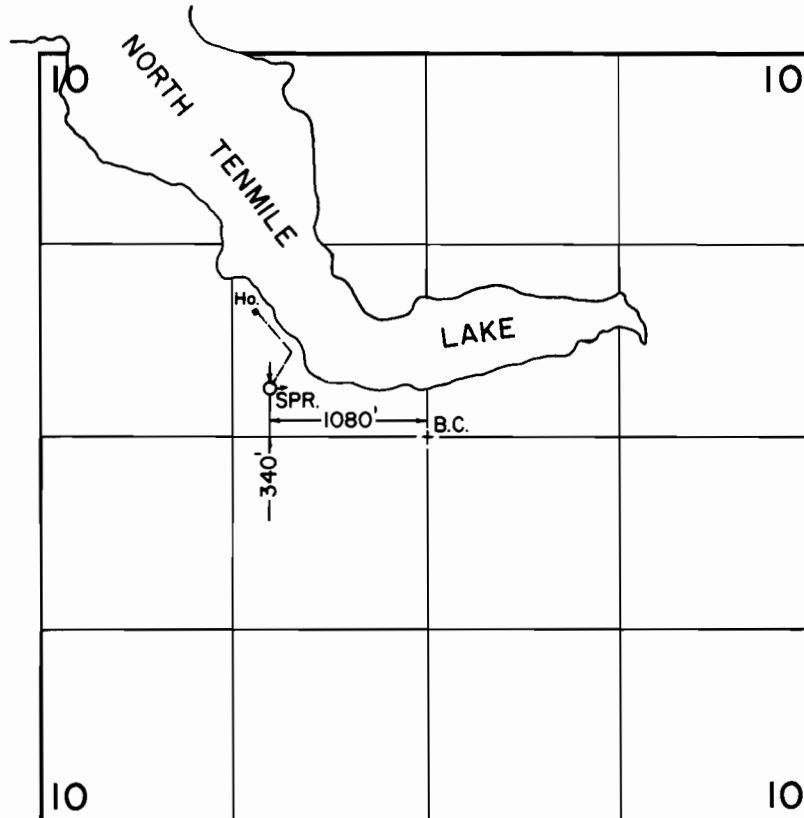

SCALE: 1" = 1320'

FINAL PROOF SURVEY UNDER

Application No. 58571... Permit No. 44297...
IN NAME OF

JAMES G. & PAISY R. YUMA

Surveyed SEPT. 17, 1988., by T. M. WARREN...