
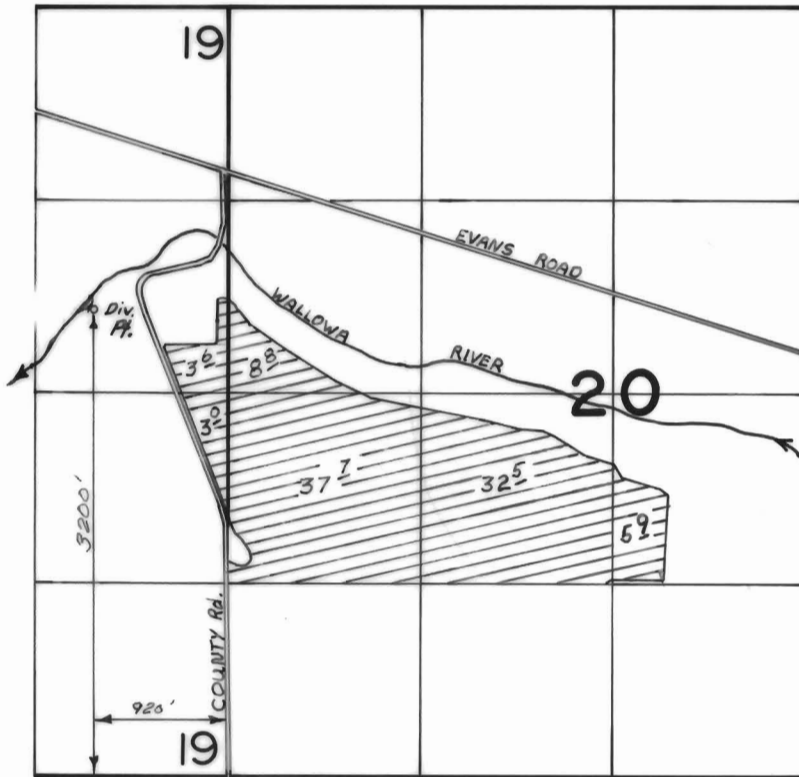


T. 1 N., R. 43 E., W.M.

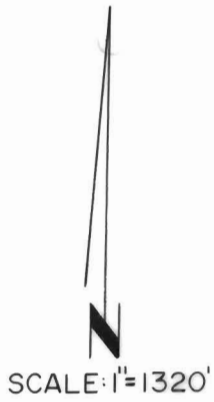

FINAL PROOF SURVEY UNDER

Application No. 59465 Permit No. 44750.....
IN NAME OF

.....THOMAS J. WILLETT.....

Surveyed Aug. 8..... 1985., by V.L. CHURCH.....