


T. 8S., R. 39E., W.M

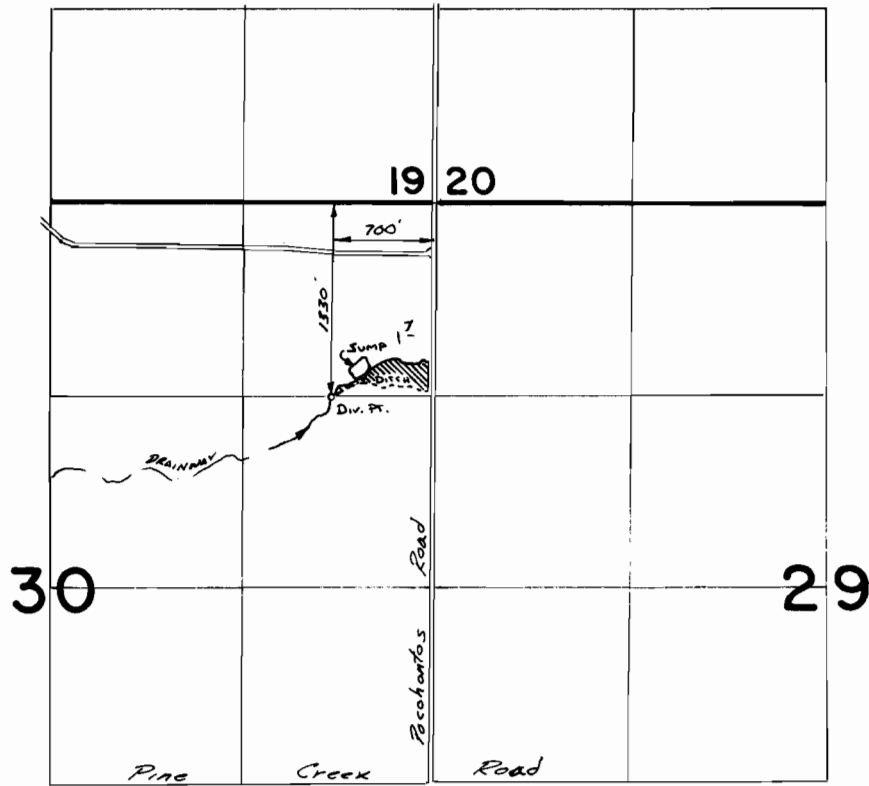

FINAL PROOF SURVEY
UNDER

Application No. **59338** Permit No. **44751**.....
IN NAME OF

.....**TRUMAN BENNETT**.....

Surveyed *Mar. 28*..... 19*83*., by *V.L. Church*.....