


T.2N., R.48E., W.M.

SCALE: 1"=1320'

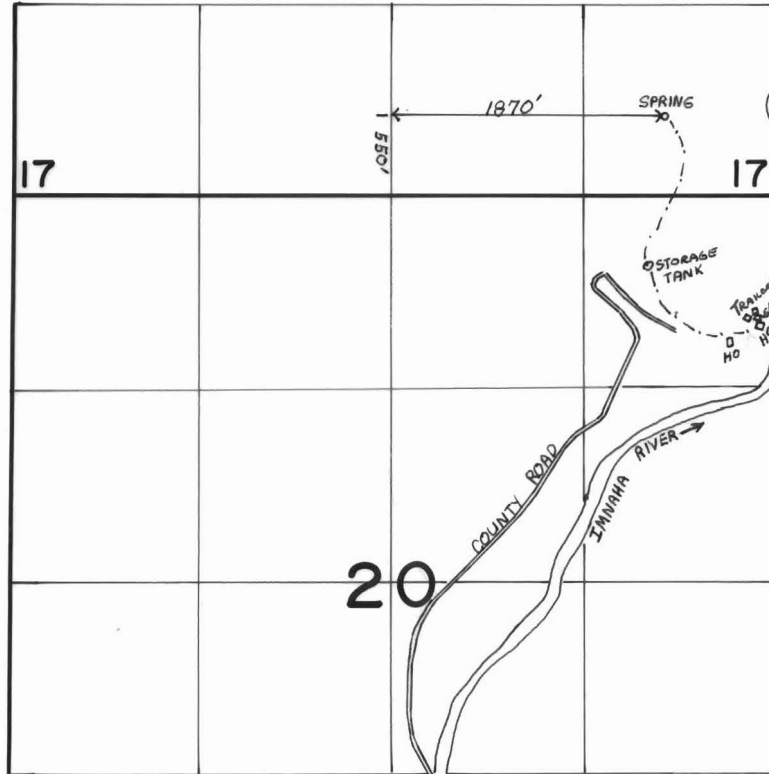

FINAL PROOF SURVEY
UNDER

Application No. .60046. Permit No. 4505L.....
IN NAME OF

Eugene Marr & John Gorsline

Surveyed Aug. 27..... 1985., by V.L. CHURCH.....