


T. 2N., R. 32E., W.M.

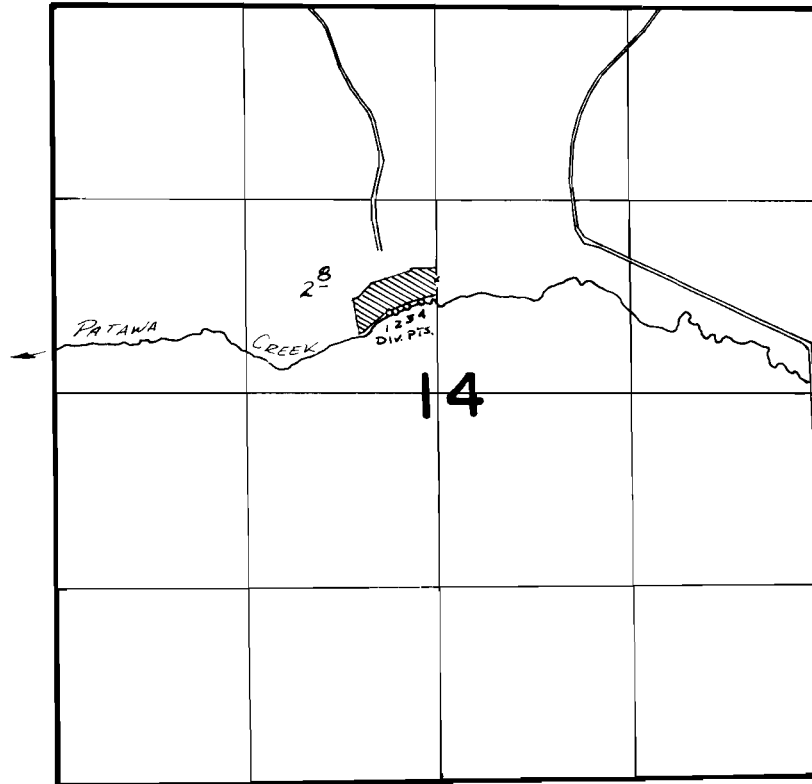

Div. Pt. 1 Loc: 560' N. & 330' W. FROM CENTER COR. SEC 14
Div. Pt. 2 Loc: 560' N. & 290' W. FROM CENTER COR. SEC 14
Div. Pt. 3 Loc: 600' N. & 200' W. FROM CENTER COR. SEC 14
Div. Pt. 4 Loc: 630' N. & 100' W. FROM CENTER COR. SEC 14

FINAL PROOF SURVEY
UNDER

Application No. **60089** Permit No. **45086**...
IN NAME OF

.....**ROBERT M. BURNS**.....

Surveyed *May 16*.... 19*83*., by *V.H. Church*.....