


T. 39 S., R. 8 W., W. M.

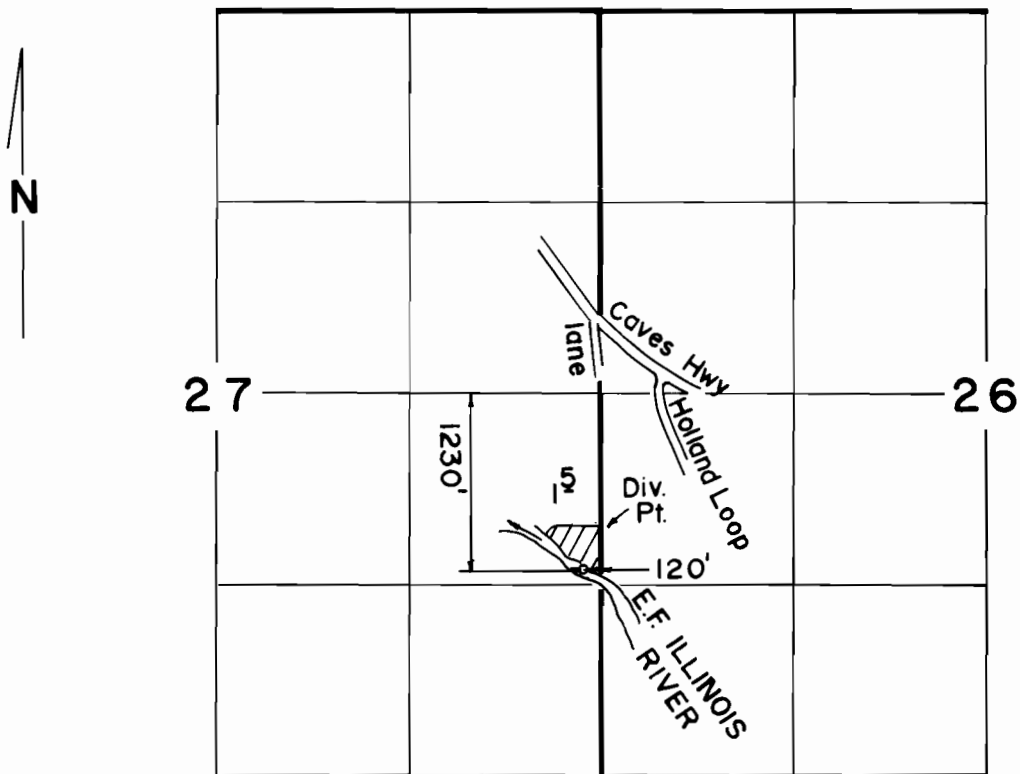

Scale: 1" = 1320'

**FINAL PROOF SURVEY**  
UNDER

Application No. **60344** Permit No. **45135**  
IN NAME OF

**EDWARD HAFER**

Surveyed JUN. 10. 1986, by B. S. JAMES.