


T. 40 S., R. 8 W., W. M.

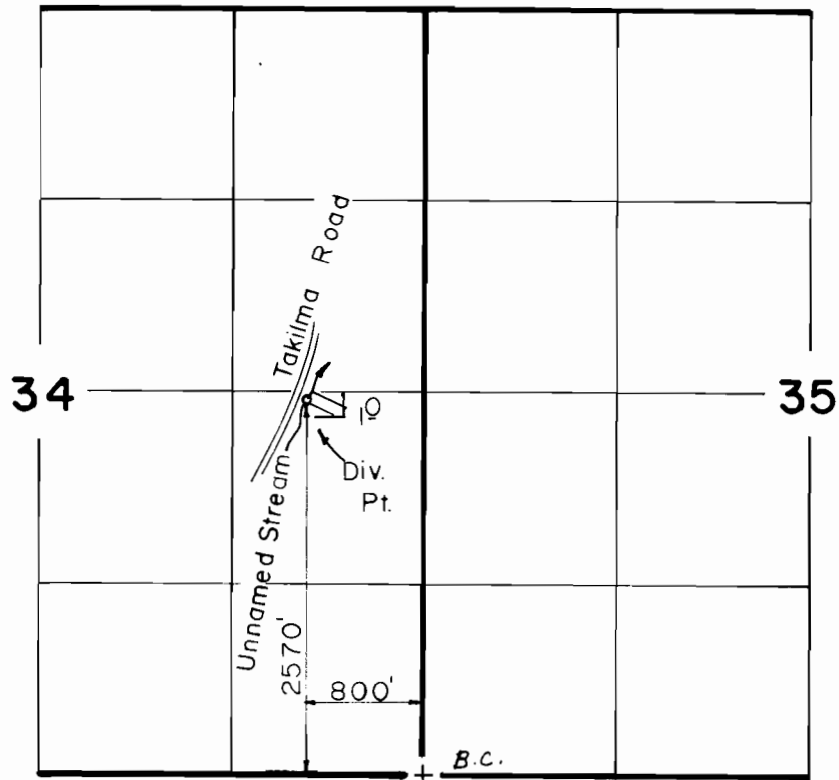

Scale: 1" = 1320'

FINAL PROOF SURVEY
UNDER

Application No. 60415 Permit No. 45138
IN NAME OF

HAZEL W. ANDERS

Surveyed APR. 15, 1986, by B. S. JAMES