


T. 14 S., R. 7 & 8 W., W.M.

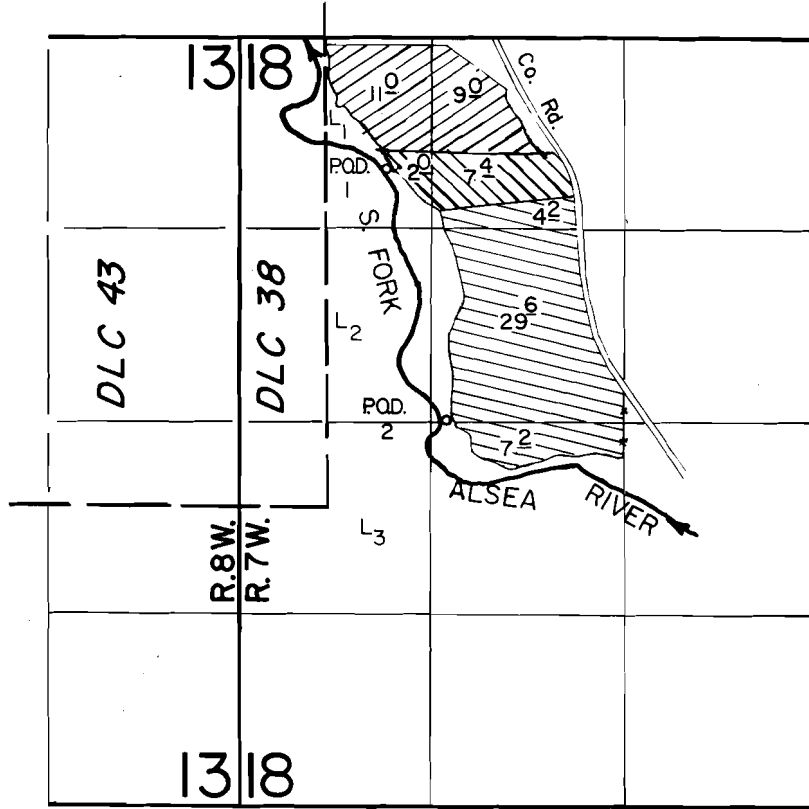

PO.D. 1 Loc. : 900' S. & 1000' E.

PO.D. 2 Loc. : 2640' S. & 1410' E., both from NW Cor. Sec. 18.

Scale : 1" = 1320'

### FINAL PROOF SURVEY UNDER

61259


45622

Application No. 60331... Permit No. 45176.....

IN NAME OF

**GRACE, G. HENNINGS**

Surveyed Oct. 26, 1987, by T. Warren

-  PO.D. 1
-  PO.D. 2
-  PO.D. 1